FILED
Date: 8/26/2008 By: C
This survey consists of:
Map: _____
Narrative: _____
Corner Rpt: 65/63-28
DOUGLAS COUNTY
SURVEYOR

OREGON CORNER RESTORATION FORM

Section 8 Township 21 South, Range 8 West
County Douglas Date 15 August 2008

Corner Description

¼ Corner
Sections 8, 9

___ Condition Report Only

___ Not Found
_X_ Renewed
___ Unrecorded
___ Surveyed In
___ Referenced Out

Previous Renewals / Surveys, etc.

Monument (s) & Accessories Found: (Condition and Source)
Found 2-1/2" brass cap dated 1945 with the following accessories:
60" D. fir stump bears S9°E 40.9' – rotted face (record S9°E 68.6')
72" D. fir stump bears S52°W 68.6' – rotted face (record S52°W 40.9')

Monument Detail

Sketch

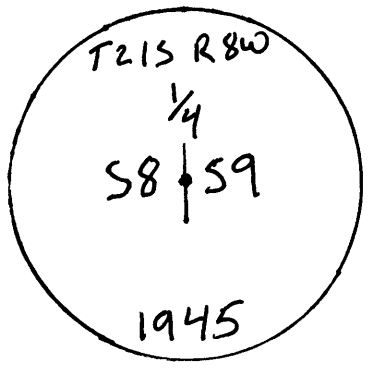

Monument Set (Procedures and Description)
None

New Accessories
17" D. fir bears S60°W 34.6' - blazed, scribed "1/4 S8 BT"
13" D. fir bears N7-1/2°W 4.3' - blazed, scribed "1/4 S8 BT"
11" D. fir bears N50-1/2°E 25.6' - blazed, scribed "1/4 S9 BT"
11" D. fir bears S45°E 35.3' - blazed, scribed "1/4 S9 BT"

Location & Comments

Corner has steel post adjacent to it. All BT's have red painted bands and yellow tags.

Compass Declination 17° East
Firm/Agency Ward NorthWest Inc.
Address P.O. Box 105
Florence, OR 97439
Party Chief Ron Rice
Notes
Witness Josh Reed

Surveyor's Seal

REGISTERED
PROFESSIONAL
LAND SURVEYOR
Ronald L Rice
OREGON
JULY 9, 2002
RONALD L. RICE
#54633 LS
Expires: 12-31-08

C.S. File No 65/63-28