FILED
Date: 10-16-2008 By: AW
This survey consists of:
Map: CS 65/64-10
Narrative:
Corner Rpt:

DOUGLAS COUNTY
SURVEYOR

C.S. File No 65/64-10

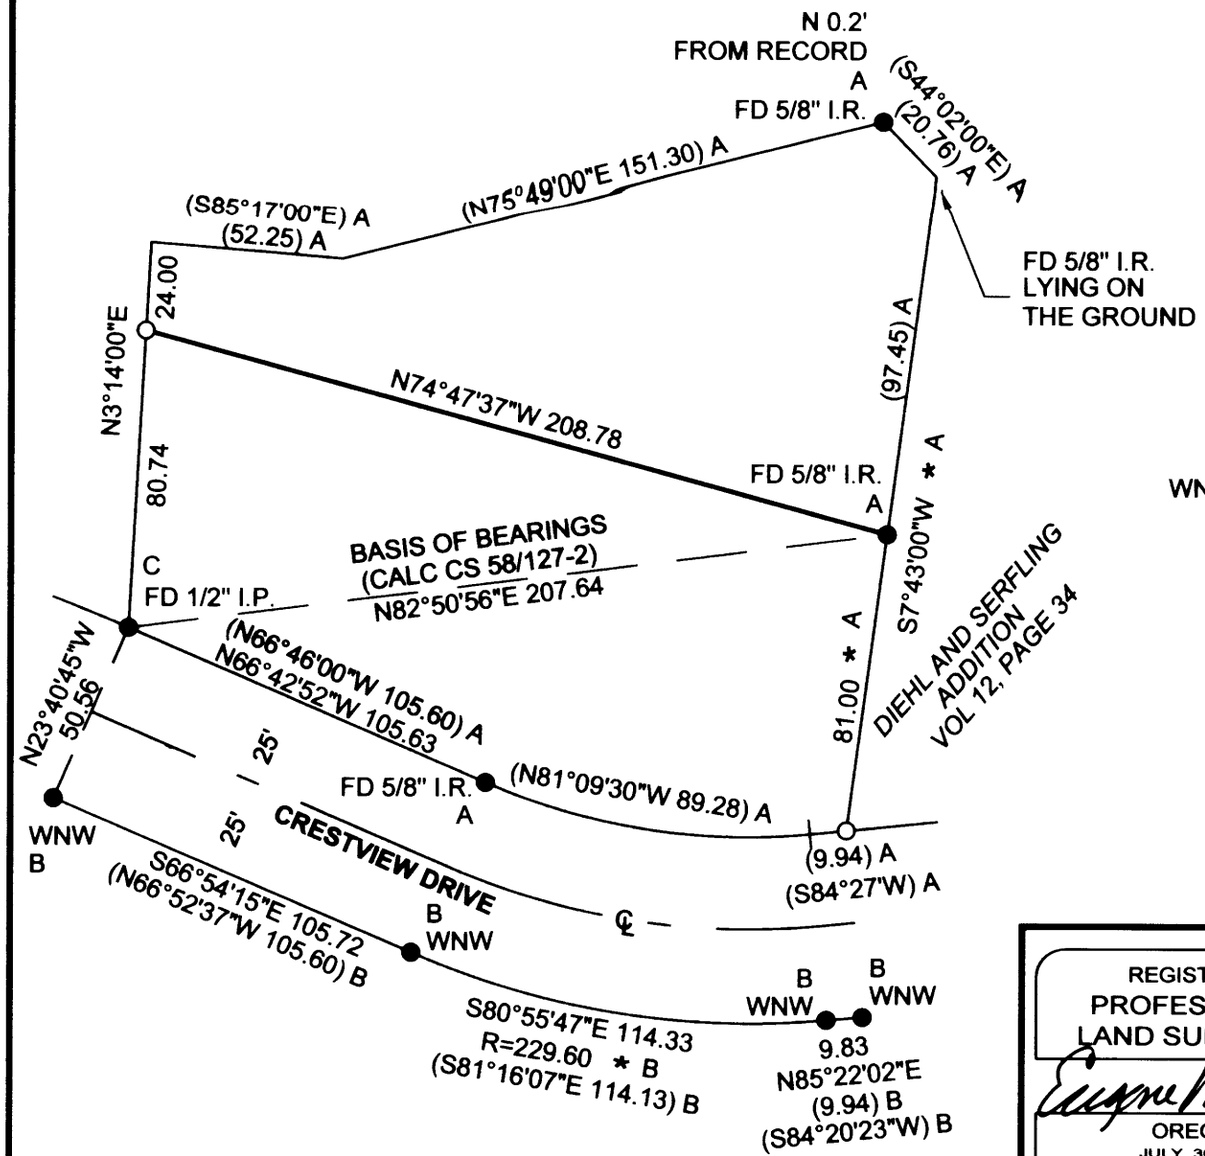

NARRATIVE:
THE PURPOSE OF THIS SURVEY WAS TO REMONUMENT THE MISSING CORNERS AS SHOWN. A SEARCH WAS CONDUCTED FOR NEARBY CORNERS OF DIEHL & SERFLING ADDITION, VOLUME 12, PAGE 34, INCLUDING THE SOUTHWEST CORNER OF LOT 1, BLOCK 1. NONE OF THE MONUMENTS SEARCHED FOR WERE FOUND. THE POSITIONS FOR THE MISSING CORNERS WERE ESTABLISHED AT RECORD POSITION BASED ON MONUMENTS FOUND FROM CSF 58/127-2.

- O INDICATES 5/8" X 30" IRON ROD SET WITH YELLOW PLASTIC CAP MARKED "WOBBE - PLS 1093".
- WNW ● INDICATES 5/8" IRON ROD FOUND WITH YELLOW PLASTIC CAP MARKED "LS 1091"
- ● INDICATES MONUMENT FOUND AS NOTED.
- ( ) INDICATES RECORD DATA.
- * INDICATES MEASURED DATA SAME AS RECORD.

EQUIPMENT USED: NIKON DTM - 521

SURVEY REFERENCES

A - C.S. FILE NO. 58/127-2
B - PARTITION PLAT 1995-0003
C - ORIGIN UNKNOWN - SHOWN AS FOUND ON CS 58/127-1

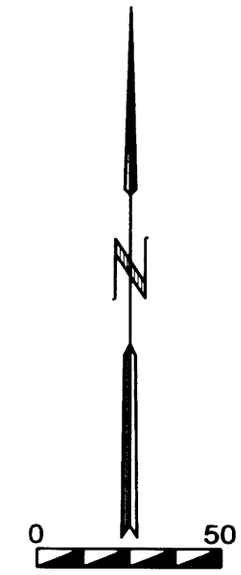

JOB F08-27

WARRANTY DEED - 2005-020093

21-12-35-33, TL 3400

HP DESIGNJET 500
JPC-4M2
HP C4844A

REGISTERED
PROFESSIONAL
LAND SURVEYOR
Eugene M. Wobbe
OREGON
JULY 30, 1976
EUGENE M. WOBBE
1093
P.L.S. EXPIRATION DATE: 6-30-2010

DC\D2008\0827 ROS.DWG

WOBBE & ASSOCIATES, INC.
510 KINGWOOD ST./ P.O. BOX 3093
FLORENCE, OR 97439

SURVEY FOR:

LINDA & DENNIS REPP

SW 1/4, SEC. 35, T21S, R12W, W.M.
REEDSPORT, DOUGLAS COUNTY, OREGON

SEPTEMBER 15, 2008
REV. OCTOBER 14, 2008

DRAWN: PC

C.S. File No 65/64-10