FILED
Date: 11/10/2009 By: JC
This survey consists of:
Map:
Narrative:
Corner Rpt: 65/66-41

DOUGLAS COUNTY SURVEYOR

OREGON CORNER RESTORATION FORM

Section 26 Township 29 S Range 7 W

County Douglas Date 10/22/2009

CORNER DESIGNATION

Corner common to Sections 26, 26½, 34½ and 35.

___ Condition Report Only
___ Not Found
X Renewed
___ Unrecorded
___ Surveyed In
___ Referenced Out

Previous Renewals/Surveys, etc.

1909 G.L.O. survey. 1924 G.L.O. resurvey/corner re-establishment.

1962 Douglas County Surveyor Renewal. 1977 D.C.S. renewal.

Monument(s) & Accessories Found: (Condition and Source)

1962/1977 Douglas County Surveyor brass cap found in good condition.

All of the previously marked bearing trees are either snags or are gone.

Monument Detail

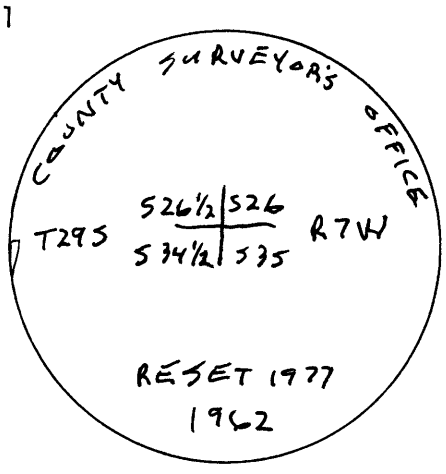

Sketch

Monument Set (Procedures and Description)

N/A

New Accessories

An 11" diam. Maple bears N.49°E., 34.1' scribed T29S R7W S26 BT

A 16" diam. Fir bears S.41°E., 52.8' scribed T29S R7W S35 BT

A 10" diam. Fir bears S.12°W., 6.3' scribed T29S R7W S34½ BT

A 15" diam. Fir bears N.49°W., 27.3' scribed T29S R7W S26½ BT

All new B.T.'s measured to center of tree at root crown.

Location & Comments

Compass Declination 18° E

Firm/Agency

David Edwards Land Surveying

P.O. Box 361 Address

Oakland, Oregon 97462 (541) 459-0512

Party Chief BM

Notes

Witness ES

Surveyor's Seal

REGISTERED PROFESSIONAL LAND SURVEYOR
David A. Edwards
OREGON
JULY 26, 1988
DAVID A. EDWARDS
2339
Renews 12/31/09

C.S. File No 65/66-41