CORNER REPORT FORM
Section 08 Township 32S Range 04W
Douglas County **Date:** 8/2009
CORNER DESIGNATION: CS 1/16

___ Condition Report only
___ Not Found
X Renewed
___ Unrecorded
___ Surveyed In
___ Referenced out

Previous Renewals/Surveys, etc:
C.S. 63/52 survey narrative, and M111-12 by
Baughman Technical Services Inc.
DeGroot - Nov. 1990

Monument(s) & Accessories Found: (Condition and Source)
20" Douglas fir, N 34 ½ E, 29.7', 1990, 5' tall stump.
12" Douglas fir, S 40 ½ E, 18.3', 1990

FILED
Date: 11/17/2009 By: X
This survey consists of:
Map
Name
Corner Rpt: CS 65/66-53
DOUGLAS COUNTY SURVEYOR

Monument Detail Sketch:

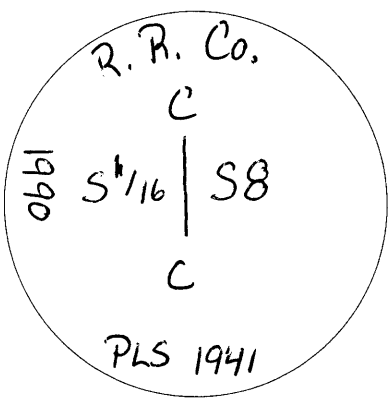

Monument Set: (Procedures and Description)

New Accessories:
11" Douglas fir, S 14 W, 6.7' measured to a nail in the side-center of stump
Scribed "CS1/16BT" with LS 2354 brass washer.
Tree has 2 healed blazes on east side.
14" Douglas fir, S 74 W, 22.2' measured to a nail in the side-center of stump
Scribed "CS1/16BT" with LS 2354 brass washer
Tree has 2 healed blazes on north side.

Location & Comments:

Compass Declination: 18°
Firm/Agency: Roseburg Forest Products
Address: PO Box 1088
Roseburg, OR 97470
Party Chief: W. Olson
Notes:
Witness: N. Danko

Surveyor's Seal

REGISTERED PROFESSIONAL LAND SURVEYOR
Mark F. Smalley
OREGON
July 26, 1988
MARK F. SMALLEY
2354
RENEWS: 6/30/2010

C.S. File No 65/66-53