

FILED

Date: 4-21-2010 By: JC

This survey consists of:

Map: _____

Narrative: _____

Corner Rpt: C.S. 65/69-8

DOUGLAS COUNTY
SURVEYOR

CORNER NOTES

MARCH 2010

BY: TONY HOSTETTER
63538 PINTAIL DR.
COOS BAY, OR 97420

FOR: WEYERHAEUSER COMPANY
98674 DELLWOOD LANE
COOS BAY, OR 97420

SE CORNER, SECTION 23, T.24 S., R.9 W., W.M.
DOUGLAS COUNTY, OREGON

FOUND: 3/4" IRON PIPE SET BY WEYERHAEUSER. (DATE UNKNOWN)

FROM WHICH:

22" FIR STUMP, WEYCO TAG & "W" NAIL,
BEARS: N 02°E, 34.3 FEET TO CENTER

33" FIR STUMP, NO MARKS, POSSIBLE OBT,
BEARS; S34°W, 17.6 FEET TO CENTER
(GLO: S35°W, 24 LKS)

36" FIR STUMP, NO MARKS, POSSIBLE OBT,
BEARS; N64°W, 6.3 FEET TO CENTER
(GLO: N64°W, 8 LKS)


19" FIR STUMP, WEYCO TAG,
BEARS: N 38°E, 19.5 FEET TO CENTER.

NEW BT:

18" FIR, WEYCO TAG & SPIKE,
BEARS: S 85°E, 55.2 FEET TO SPIKE.

SE 23-24-9.DOC

C.S. File No 65/69-8

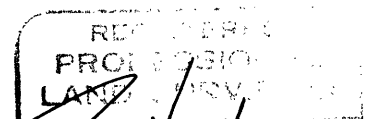

EXPIRES: 6/30/11