

FILED

Date: 4-21-2010 By: J

This survey consists of:

Map: _____

Narrative: _____

Corner Rpt: 65/69-12

DOUGLAS COUNTY
SURVEYOR

CORNER NOTES

MARCH 2010

BY: TONY HOSTETTER
63538 PINTAIL DR.
COOS BAY, OR 97420

FOR: WEYERHAEUSER COMPANY
98674 DELLWOOD LANE
COOS BAY, OR 97420

SW 1/16 CORNER, SECTION 31, T.26 S., R.7 W., W.M.
DOUGLAS COUNTY, OREGON


FOUND: 5/8" REBAR W/PLASTIC CAP AND BTS AS DESCRIBED ON SURVEY
PLAT M134-63.

EXCEPT: 14" FIR BT @ N52°E IS NOW A WINDFALL.

NEW BT:

12" FIR, WEYCO TAG & SPIKE,
BEARS: N 10°W, 17.4 FEET TO SPIKE.

SW 1-16 31-26-7.DOC

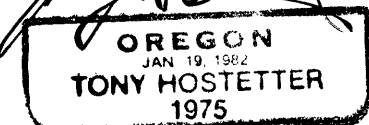

C.S. File No 65/69-12

EXPIRES: 6/30/11