C.S. File No 65/70-1

FILED
Date: 3/8/2010 By: KW
This survey consists of:
Map: CS 65/70-1
Narrative:
Corner Rpt:

DOUGLAS COUNTY
SURVEYOR

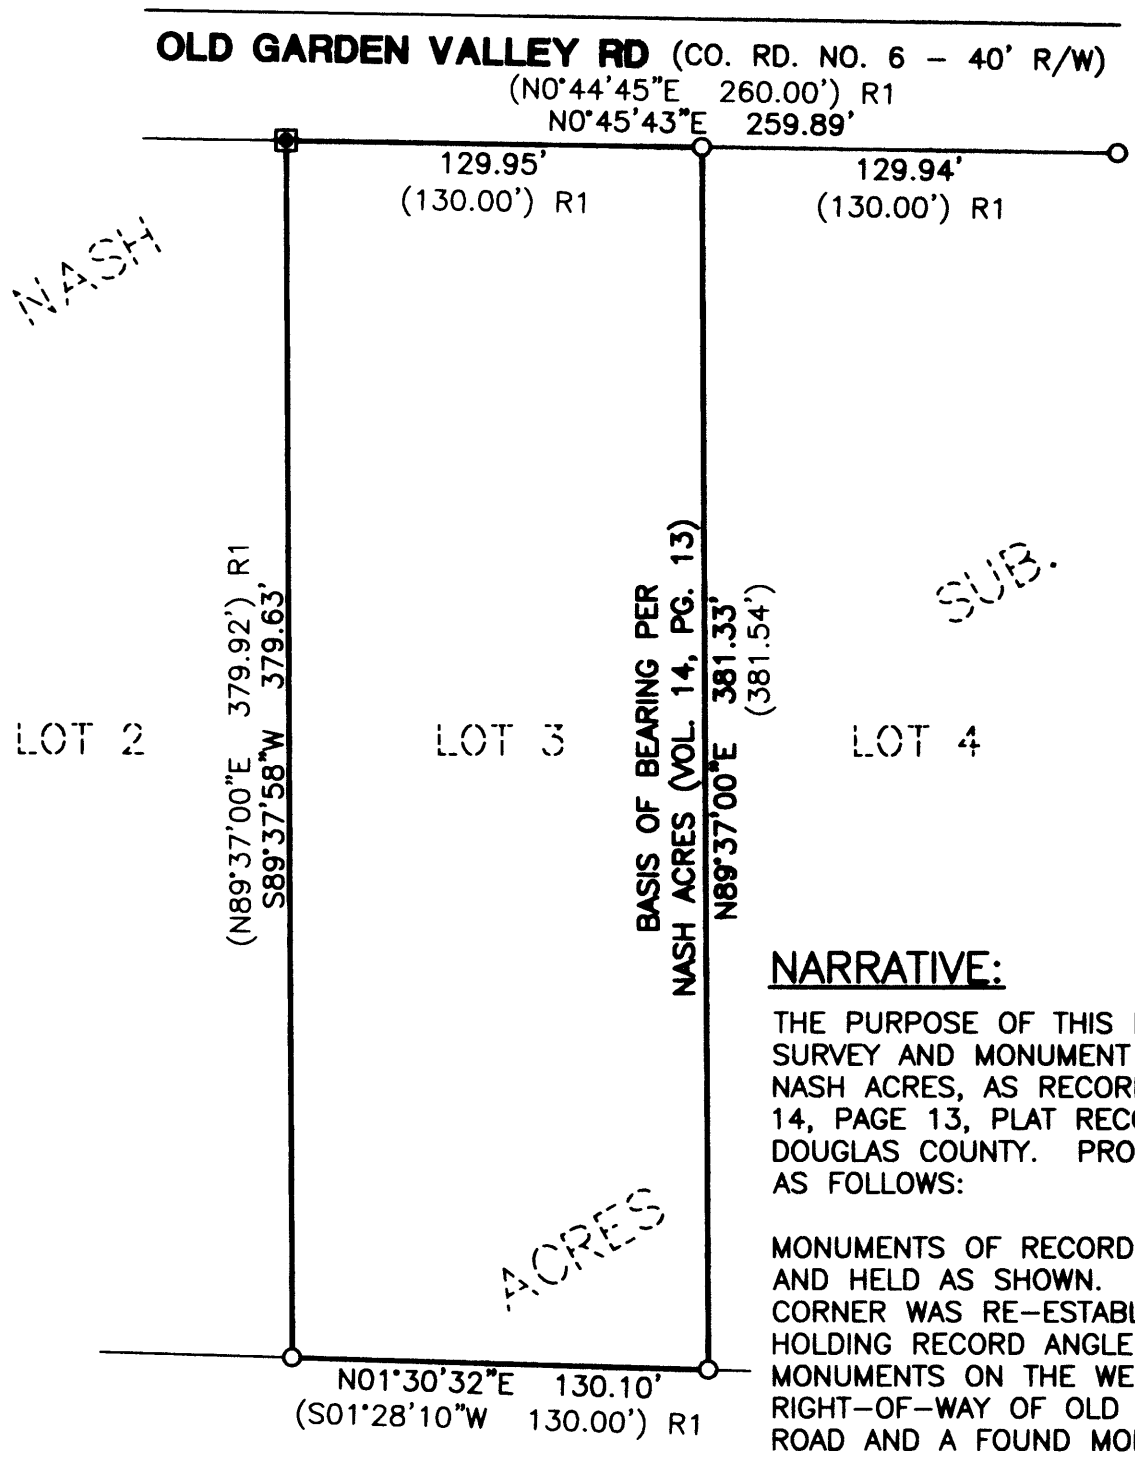

NARRATIVE:

THE PURPOSE OF THIS MAP IS TO SURVEY AND MONUMENT LOT 3 OF NASH ACRES, AS RECORDED IN VOLUME 14, PAGE 13, PLAT RECORDS OF DOUGLAS COUNTY. PROCEDURE WAS AS FOLLOWS:

MONUMENTS OF RECORD WERE TIED AND HELD AS SHOWN. THE NORTHEAST CORNER WAS RE-ESTABLISHED BY HOLDING RECORD ANGLE FROM FOUND MONUMENTS ON THE WESTERLY RIGHT-OF-WAY OF OLD GARDEN VALLEY ROAD AND A FOUND MONUMENT AT THE NORTHWEST CORNER OF THE PROPERTY.

FIELD CREW: RON QUIMBY AND DEREK FEIGEL

EQUIPMENT: NIKON TOTAL STATION AND TDS RANGER DATA COLLECTOR

OFFICE: RON QUIMBY/DEREK FEIGEL

DRAFTING: DEREK FEIGEL

LEGEND:

( ) R1 — RECORD AS PER NASH ACRES (VOLUME 14, PAGE 13)

◘ — SET 5/8" x 30" IRON ROD w/ CAP MARKED "I.E. ENGINEERING"

O — FOUND 5/8" IRON ROD

REGISTERED
PROFESSIONAL
LAND SURVEYOR

OREGON
JULY 14, 1978
RONALD A. QUIMBY
1654

EXPIRES: 12/31/2010

SURVEY

LYING IN THE NORTHWEST QUARTER OF SECTION 29, TOWNSHIP 26 SOUTH, RANGE 6 WEST, W.M., DOUGLAS COUNTY, OREGON

SURVEYED FOR:
KEN NICHOLS
113 WEST CARDINAL
ROSEBURG, OR. 97471

i.e. ENGINEERING
809 S.E. Pine Street
Roseburg, Oregon 97470
PHONE (541) 673-0166
FAX (541) 440-9392

DATE: FEB., 2010
DWG: DAF
JOB NO. 2417-01
SCALE: 1" = 60'
PAGE: 1 OF 1

C.S. File No 65/70-1