AFFIDAVIT OF CORRECTION TO SURVEY #ST HWY I5-016

I, Christine V. Blevins, being duly sworn, depose and say that I am the surveyor who surveyed the property as depicted, filed and recorded in survey #ST HWY I5-016A-K, Douglas County, Oregon Survey Records on April 4, 2004; and

The following corrections to sheet 6 of 11 (I5-016F) of said survey are necessary and are as follows:

Angle points in the Interstate 5 westerly boundary between the right of way centerline stations 2238+84.11 to 2247+00 shall be revised as follows:

Station 2238+84.11, 150 feet right, in a straight line to
Station 2242+00.00, 170 feet right, continuing parallel to centerline to
Station 2244+50.00, 170 feet right, and in a straight line to
Station 2247+00.00, 125 feet right

These corrections are being made based on information from ODOT RW map #8B-26-7 and its' accompanying Correction Bargain and Sale Deed to Evans Products Company, a Delaware corporation, recorded September 4, 1964 in Book 338, Page 270 of the Douglas County Book of Records (ODOT Right of Way File No. 35605).

Christine V. Blevins

CHRISTINE V. BLEVINS
Registered Professional Land Surveyor #2669
Oregon Department Of Transportation
3500 NW Stewart Parkway, Suite 140
Roseburg, Oregon 97470

REGISTERED
PROFESSIONAL
LAND SURVEYOR

Christine V. Blevins

OREGON
JULY 19, 1994
CHRISTINE V. BLEVINS
2669

EXPIRES: DEC. 31, 2011

DOUGLAS COUNTY OFFICIAL RECORDS
BARBARA E. NIELSEN, COUNTY CLERK

2010-009175

$41.00

00272982201000091750010016

06/04/2010 10:59:54 AM

PLAT-CORR Cnt=1 Stn=1 RECEIPTCOUNTER
$5.00 $11.00 $15.00 $10.00

NOTARY CERTIFICATE

STATE OF OREGON)
) ss
COUNTY OF DOUGLAS)

Subscribed and sworn to before me this 04 day of June, 2010.

Carmen Miles
Notary Public for the State of Oregon
My Commission Expires_____

OFFICIAL SEAL
CARMEN MILES
NOTARY PUBLIC - OREGON
COMMISSION NO 419789
MY COMMISSION EXPIRES JULY 31, 2011

COUNTY SURVEYOR APPROVAL

I, Romanso E. Ware, Douglas County Surveyor, do hereby certify that said Affidavit of Correction for Survey #ST HWY I5-016 has been examined by me and that it complies with ORS 209.255.

Barry Smith DEPUTY 6-4-2010
Romanso E. Ware, County Surveyor

FOR

FILED
Date: 6/7/2010 By: JC
This survey consists of:
Map: STHWI5-016F
Narrative:
Corner Rpt: CS 65/71-2

DOUGLAS COUNTY
SURVEYOR

C.S. File No 65/71-2

END OF DOCUMENT

SE 1/4 SEC. 13 AND NE 1/4 & SE 1/4 SEC. 24, T. 26 S., R. 6 W., W.M.

#ST HWY I5-016

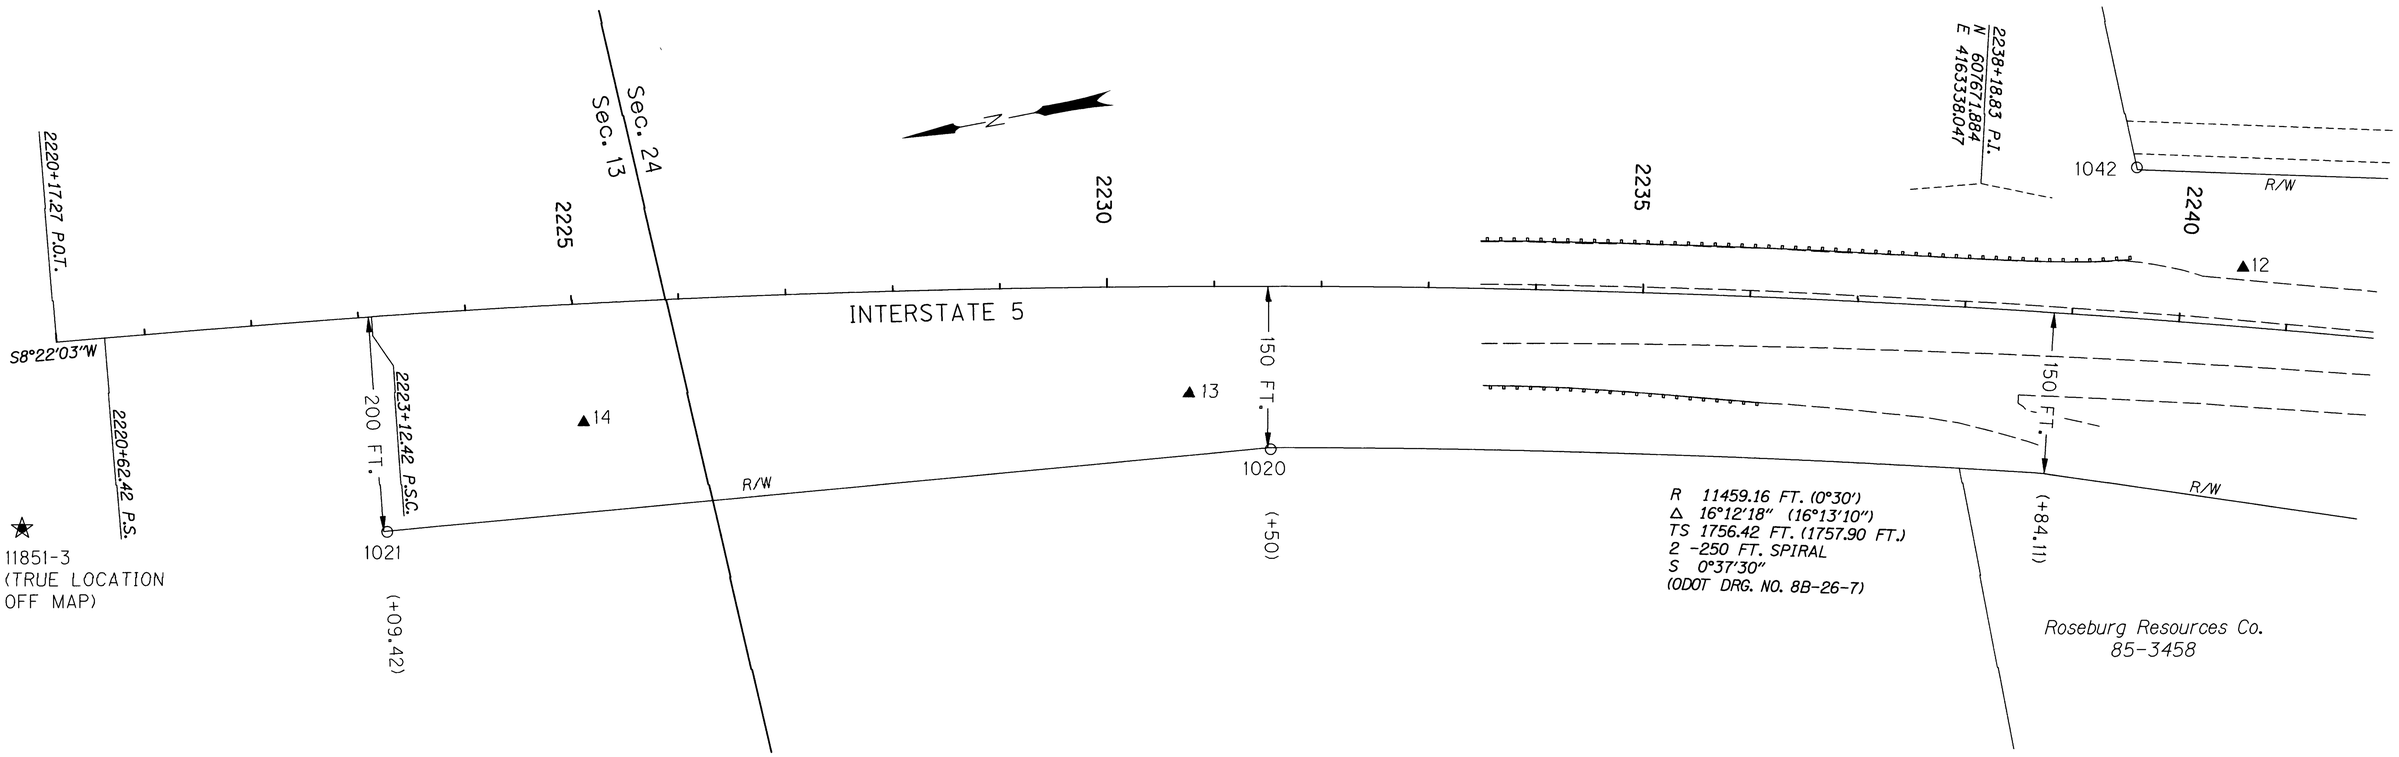

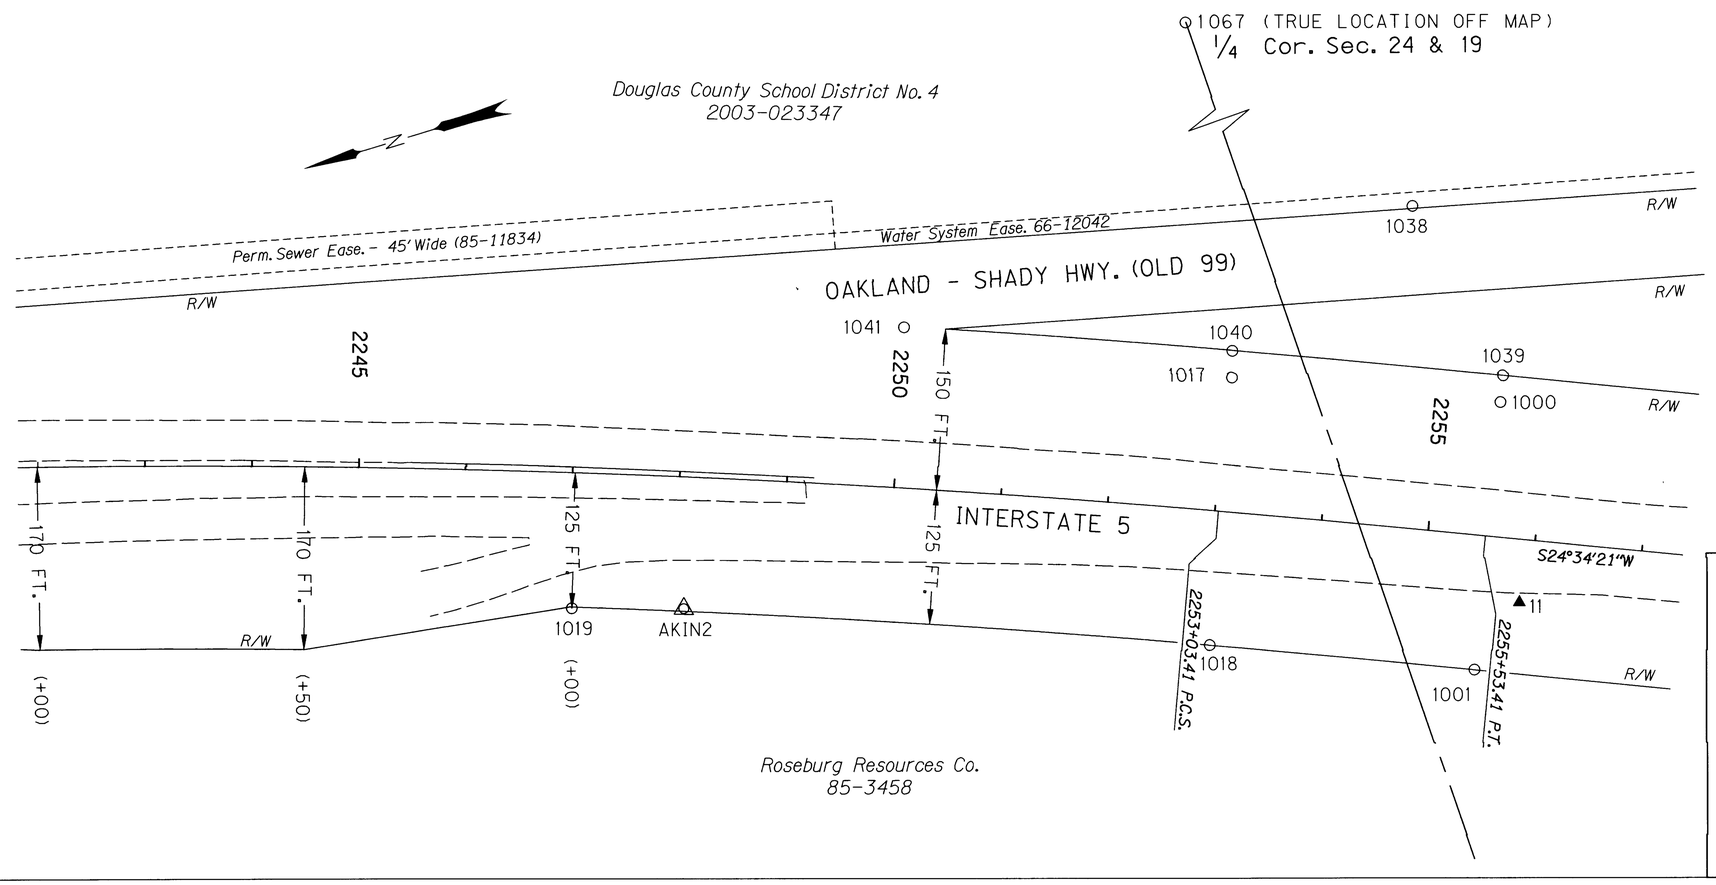

SCALE 1" = 100'

100 50 0 100 200 300
FEET

LEGEND	
( )	RECORD DATA
▲	SET NETWORK POINT
★	FOUND GPS STATION
○	FOUND MONUMENT
△	FOUND MONUMENT USED AS NETWORK POINT

REGISTERED
PROFESSIONAL
LAND SURVEYOR

FOR INFO. ONLY

OREGON
JULY 19, 1994
CHRISTINE V. BLEVINS
2669

EXPIRES: DEC. 31, 2011

OREGON DEPARTMENT OF TRANSPORTATION

HORIZONTAL CONTROL, RECOVERY AND RETRACEMENT MAP

I-5: EXIT 129 / N. UMPQUA RIVER (WINCHESTER) BRIDGES

INTERSTATE 5 AND OAKLAND-SHADY HIGHWAY

DOUGLAS COUNTY

REVISED JUNE 2, 2010 FOR ODOT REGION 3

3500 NW STEWART PARKWAY ROSEBURG, OR 97470

SHEET 6 OF 11

CS 65/71-2