

FILED

Date: 2/11/2011 By: JC

This survey consists of:

Map: _____

Narrative: _____

Corner Rpt: CS 65/72-5

CORNER NOTES

JANUARY 2011

DOUGLAS COUNTY
SURVEYOR

BY: TONY HOSTETTER
63538 PINTAIL DR.
COOS BAY, OR 97420

FOR: WEYERHAEUSER COMPANY
98674 DELLWOOD LANE
COOS BAY, OR 97420

N 1/4 CORNER, SECTION 21, T.24 S., R.9 W., W.M.
DOUGLAS COUNTY, OREGON

FOUND: 36" FIR STUMP WITH WEYCO TAG WHICH READS " S 081/2°E, 40.2 FEET, 1956".

Weyerhaeuser Company records intricate that both original bearing trees for this corner were found in 1956.

SET 5/8" REBAR W/PLASTIC CAP MARKED "HOSTETTER LS 1975"

FROM WHICH:

36" FIR STUMP, OBT, DESCRIBED ABOVE,
BEARS: N08 1/2°W, 40.2 FEET
(GLO: 30" FIR, N 08 1/2°W, 61 LKS)



NEW BTS:

12" FIR STUMP, WEYCO TAG,
BEARS: N 34°E, 30.8 FEET TO 12" SPIKE, PLACED IN ROOT COLLAR.

14" FIR STUMP, WEYCO TAG,
BEARS: S 52°E, 46.5 FEET TO 12" SPIKE, PLACED IN ROOT COLLAR.

16" FIR STUMP, WEYCO TAG,
BEARS; N 21° W, 45.5 FEET TO 12" SPIKE, PLACED IN ROOT COLLAR.

NQU 21-24-9.DOC

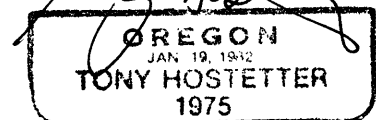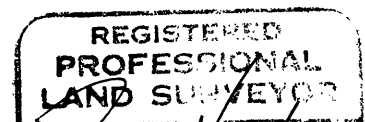

C.S. File No 65/72-5