

FILED

Date: 4-6-2011 By: JC

This survey consists of:

Map: _____

Narrative: _____

Corner Rpt: CS 65/72-24

CORNER NOTES

MARCH 2011

BY: TONY HOSTETTER
63538 PINTAIL DR.
COOS BAY, OR 97420

DOUGLAS COUNTY
SURVEYOR

FOR: WEYERHAEUSER COMPANY
98674 DELLWOOD LANE
COOS BAY, OR 97420

CC CORNER, SECTION 10 & 15 ONLY, T.24 S., R.9 W., W.M.
DOUGLAS COUNTY, OREGON

FOUND: 3/4" IRON PIPE
(1968 DOUGAS COUNTY SURVEYORS OFFICE BRASS CAP IS GONE).

FROM WHICH:

45" FIR STUMP, ORIGINAL BT, WEYCO TAG,
BEARS; S 31°W, 25.1 FEET



46" FIR STUMP, ORIGINAL BT, WEYCO TAG,
BEARS; N 62 1/2°W, 53.5 FEET.

NEW BTS:

23" FIR, WEYCO TAG,
BEARS; S 45°E, 32.5 FEET TO SPIKE IN ROOT COLLAR.

14" FIR, WEYCO TAG,
BEARS; S 18°W, 27.5 FEET TO SPIKE IN ROOT COLLAR.

12" FIR, WEYCO TAG,
BEARS; N 55°W, 23.7 FEET TO SPIKE IN ROOT COLLAR.

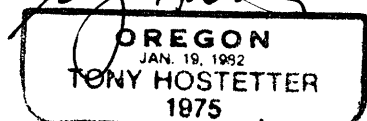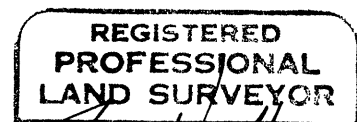

EXPIRES: 6/30/11

C.S. File No 65/72-24