FILED
Date: 12-7-2011 By: JC
For This survey consists of:
Map: ST HWY I5-023
Narrative:
~~Corner Rpt~~: CS 65/73-2

DOUGLAS COUNTY
SURVEYOR

DOUGLAS COUNTY OFFICIAL RECORDS
BARBARA E. NIELSEN, COUNTY CLERK
2011-017437
NO FEE
00309358201100174370010015
12/07/2011 10:10:10 AM
PLAT-CORR Cnt=1 Stn=1 receiptcounter
This is a no fee document

AFFIDAVIT OF CORRECTION TO SURVEY # ST. HWY. I5 – 023

I, Marshall R. Wagstaff, being duly sworn, depose and say that I am the Region 3 Surveyor in District 7 for the Oregon Department of Transportation currently in responsible charge of this survey. James M. Stanley, who was under my supervision and is now retired, originally filed the survey of the property as depicted, and the survey was recorded as survey # St. Hwy. I5-023, Douglas County, Oregon Survey Records; and the following corrections to said survey, sheet 11 of 13 (ST. HWY. I5-023K) is necessary and is as follows and as shown below:

1. The location of the North line of the Levi Knott D.L.C. 53 is now moved to pass through point 1038 and rotated to match the record angle between the right of way of interstate 5 and the North line of the D.L.C. as per survey M78-22.

2. The West right of way line near station 1780+00 is now corrected to where the North line of the Levi Knott D.L.C. 53 defines the line where the width changes from 300 feet from center line to 125 feet (the perpendicular line that was drawn in error has been removed).

3. A missing false call line (dotted line), which defines direction of a line not the distance, was extended Southerly to point 1040.

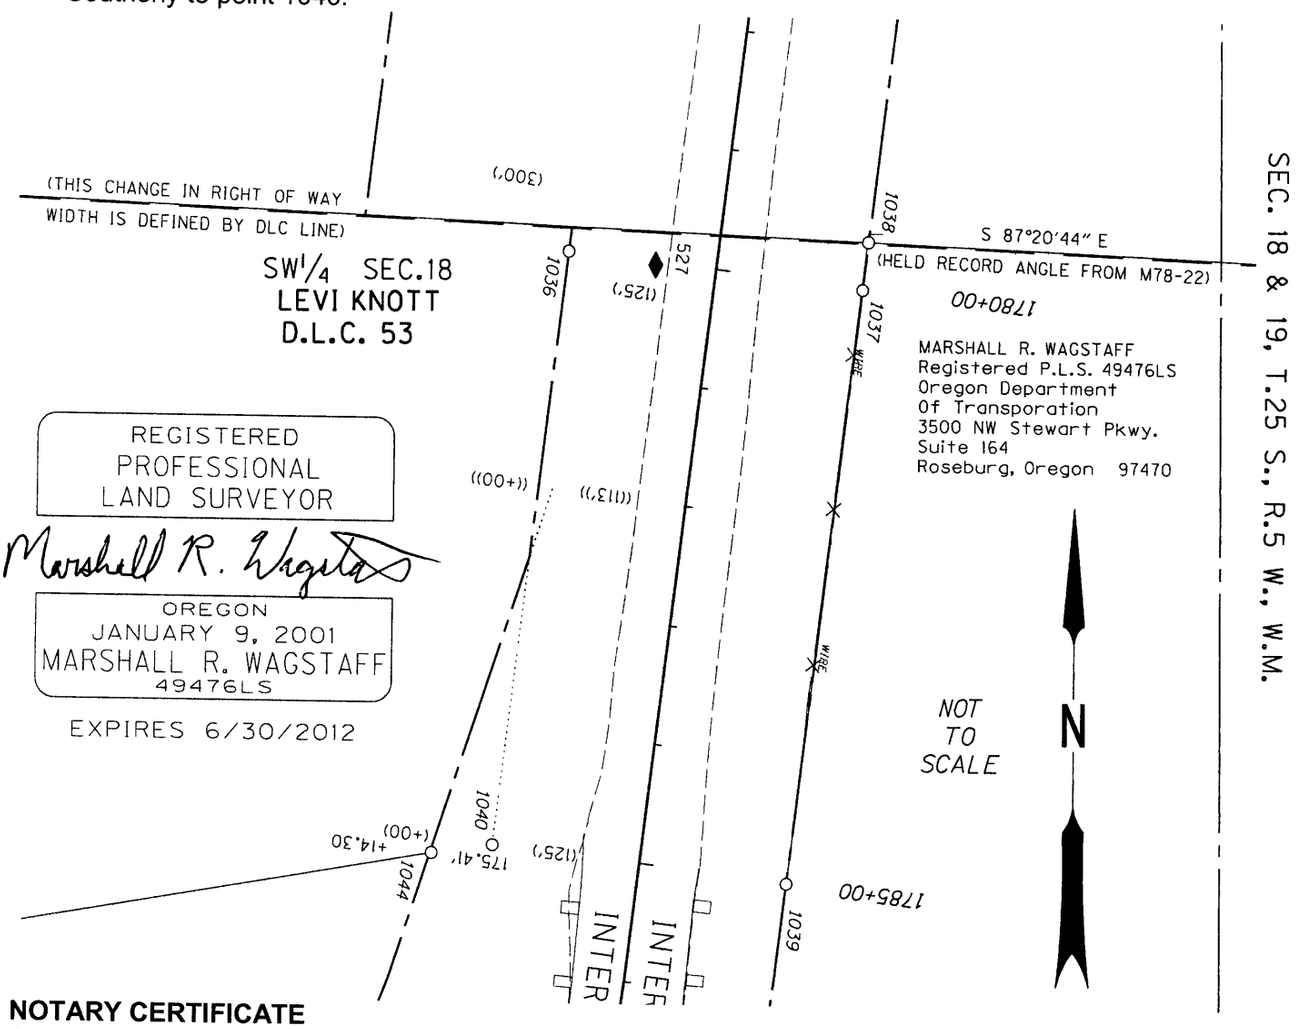

REGISTERED
PROFESSIONAL
LAND SURVEYOR
Marshall R. Wagstaff
OREGON
JANUARY 9, 2001
MARSHALL R. WAGSTAFF
49476LS
EXPIRES 6/30/2012

NOTARY CERTIFICATE
STATE OF OREGON
COUNTY OF DOUGLAS

Subscribed and sworn to before me this 6 day of Dec., ~~2002~~ 2011.

Nancy A. Winchell
Notary Public for the State of Oregon
My Commission Expires Oct. 20, 2013

OFFICIAL SEAL
NANCY A WINCHELL
NOTARY PUBLIC-OREGON
COMMISSION NO. 442244
MY COMMISSION EXPIRES OCTOBER 20, 2013

COUNTY SURVEYOR APPROVAL
I, Randall W. Smith, Douglas County Surveyor, do hereby certify that said Affidavit of Correction for Survey # St. Hwy. I5-023 has been examined by me and that it complies with ORS 209.255.

Randall W. Smith, County Surveyor

C.S. File No 65/73-2