Douglas County Official Records
Patricia K. Hitt, County Clerk
2013-015258
0035401120130015258001001 0
NO FEE
PLAT-CORR Cnt=1 Stn=13 CAROL 08/30/2013 03:43:42 PM
This is a no fee document

AFFIDAVIT OF CORRECTION FOR:
Record of Survey M 165-61

I, Carl A. Sweeden, being duly sworn, depose and say that I am the surveyor who prepared and filed Record of Survey M 165-61 in the Douglas County Surveyors records; and

The following correction to said survey is necessary and is as follows:
1. All measured bearings need to be rotated -0°12'06"
2.

The present fee owner(s) of the property materially affected by said Affidavit is as follows:
1. Rome Creek Timber

Carl A. Sweeden

Carl A. Sweeden
Registered Professional Land Surveyor # LS 2752
Sweeden Land Surveying
558 SE Jackson Street, Roseburg Oregon 97470
541-672-8344

NOTARY CERTIFICATE

STATE OF OREGON)
) ss
COUNTY OF DOUGLAS)

Subscribed and sworn to before me this 30 day of August, 2013.

Carmen Miles
Notary Public for the State of Oregon
My Commission Expires July 31, 2015

OFFICIAL SEAL
MARIA DEL CARMEN MILES
NOTARY PUBLIC-OREGON
COMMISSION NO. 469601
MY COMMISSION EXPIRES JULY 31, 2015

APPROVAL

I, Randy W. Smith, Douglas County Surveyor, do hereby certify that said affidavit of correction for Record of Survey M 165-61 has been examined by me and that it complies with O.R.S. 92.170.
209.255

Randy W Smith 8-30-2013
Randy W. Smith
Douglas County Surveyor

FILED
Date: 9-3-2013 By: JC
This survey consists of:
FOR Map: M165-61
Narrative:
~~Corner Rpt~~: CS 65/73-9 A&B

DOUGLAS COUNTY
SURVEYOR

C.S. File No 65/73-9 A

RECORD OF SURVEY
OF SECTION 2, T. 31 S., R. 4 W. W. M.
DOUGLAS COUNTY, OREGON - AUGUST 2013

FILED
Date: 9-3-2013 By: SC
This survey consists of:
Map: M 165-61
Narrative:
Corner Rpt: CS 65/73-9 A&B
FOR Aff of Correction
DOUGLAS COUNTY SURVEYOR

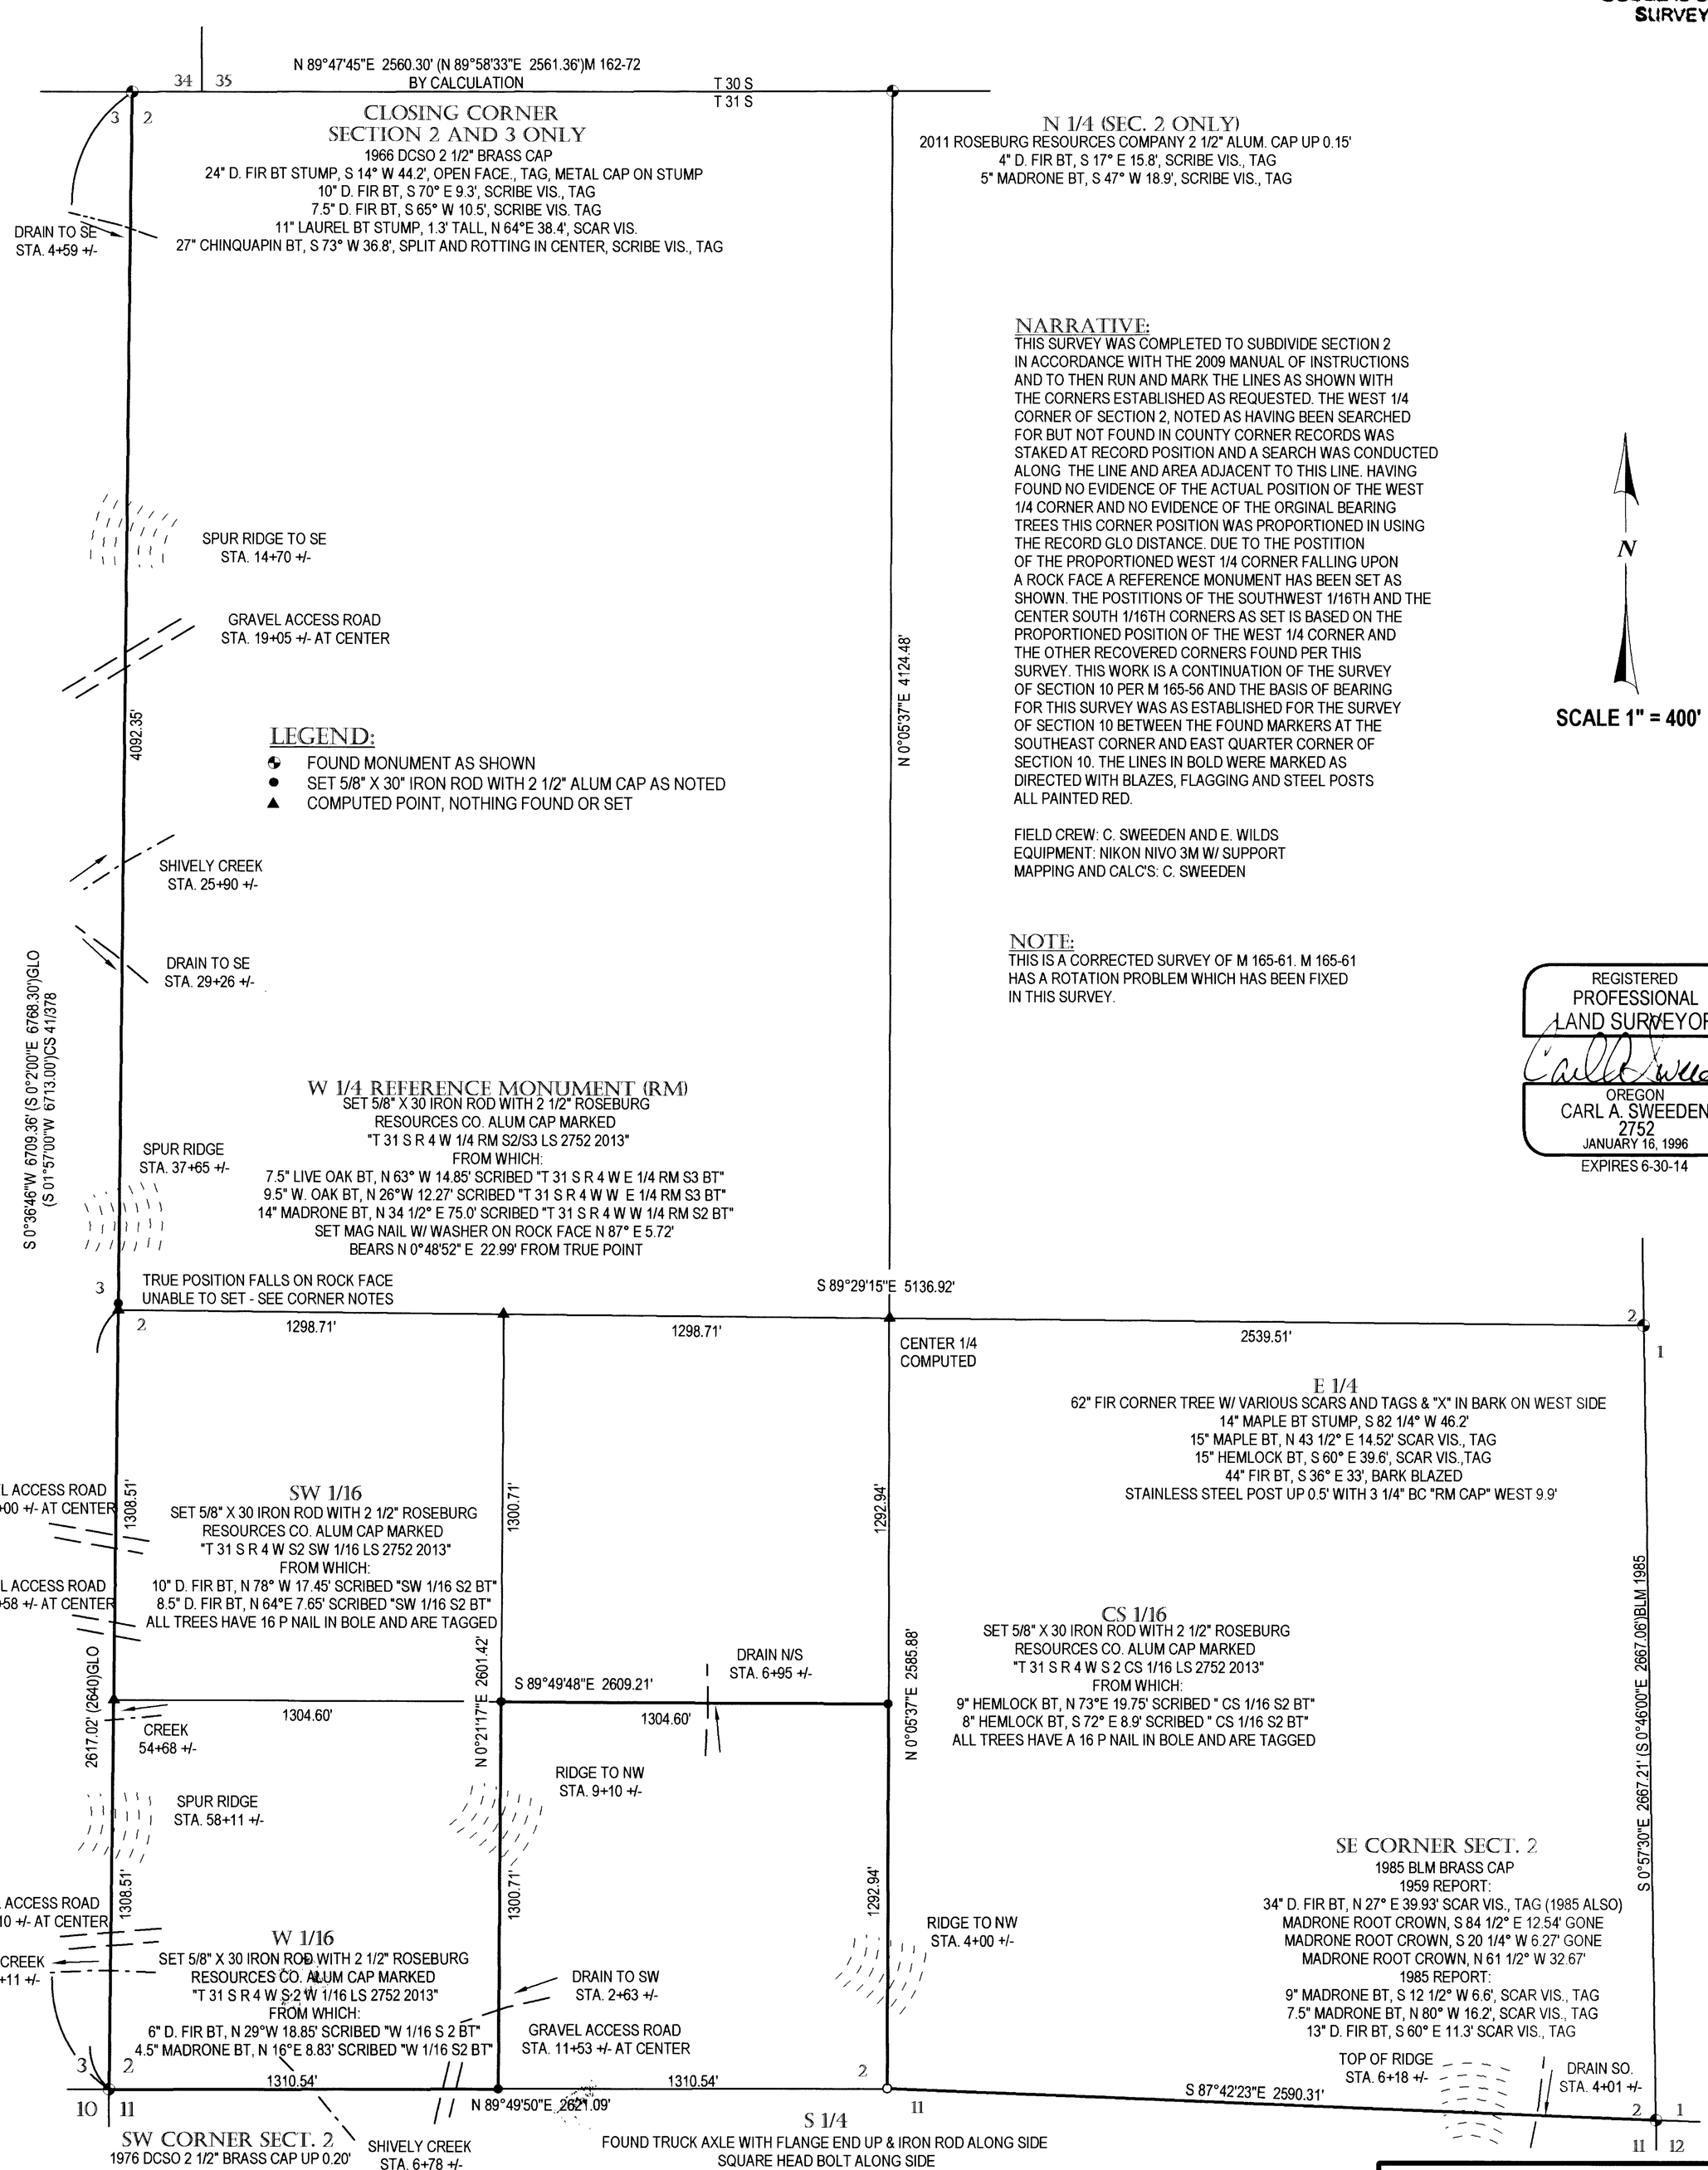

NARRATIVE:
THIS SURVEY WAS COMPLETED TO SUBDIVIDE SECTION 2 IN ACCORDANCE WITH THE 2009 MANUAL OF INSTRUCTIONS AND TO THEN RUN AND MARK THE LINES AS SHOWN WITH THE CORNERS ESTABLISHED AS REQUESTED. THE WEST 1/4 CORNER OF SECTION 2, NOTED AS HAVING BEEN SEARCHED FOR BUT NOT FOUND IN COUNTY CORNER RECORDS WAS STAKED AT RECORD POSITION AND A SEARCH WAS CONDUCTED ALONG THE LINE AND AREA ADJACENT TO THIS LINE. HAVING FOUND NO EVIDENCE OF THE ACTUAL POSITION OF THE WEST 1/4 CORNER AND NO EVIDENCE OF THE ORGINAL BEARING TREES THIS CORNER POSITION WAS PROPORTIONED IN USING THE RECORD GLO DISTANCE. DUE TO THE POSTITION OF THE PROPORTIONED WEST 1/4 CORNER FALLING UPON A ROCK FACE A REFERENCE MONUMENT HAS BEEN SET AS SHOWN. THE POSTITIONS OF THE SOUTHWEST 1/16TH AND THE CENTER SOUTH 1/16TH CORNERS AS SET IS BASED ON THE PROPORTIONED POSITION OF THE WEST 1/4 CORNER AND THE OTHER RECOVERED CORNERS FOUND PER THIS SURVEY. THIS WORK IS A CONTINUATION OF THE SURVEY OF SECTION 10 PER M 165-56 AND THE BASIS OF BEARING FOR THIS SURVEY WAS AS ESTABLISHED FOR THE SURVEY OF SECTION 10 BETWEEN THE FOUND MARKERS AT THE SOUTHEAST CORNER AND EAST QUARTER CORNER OF SECTION 10. THE LINES IN BOLD WERE MARKED AS DIRECTED WITH BLAZES, FLAGGING AND STEEL POSTS ALL PAINTED RED.

FIELD CREW: C. SWEEDEN AND E. WILDS
EQUIPMENT: NIKON NIVO 3M W/ SUPPORT
MAPPING AND CALC'S: C. SWEEDEN

N

SCALE 1" = 400'

NOTE:
THIS IS A CORRECTED SURVEY OF M 165-61. M 165-61 HAS A ROTATION PROBLEM WHICH HAS BEEN FIXED IN THIS SURVEY.

REGISTERED
PROFESSIONAL
LAND SURVEYOR
OREGON
CARL A. SWEEDEN
2752
JANUARY 16, 1996
EXPIRES 6-30-14

SURVEY FOR:
ROME CREEK TIMBER
P. O. BOX 1088
ROSEBURG, OREGON 97470

Sweeden Land Surveying
Carl A. Sweeden
P.L.S.
Conventional & Global Positioning
Surveying Systems
558 S. E. Jackson St., Roseburg, OR. 97470
Tel. 541-672-8344, Fax 541-672-1787

C.S. File No 65/73-9B