

FILED

Date: 2-8-2012 By: JC
This survey consists of:
Map: _____
Narrative: _____
Corner Rpt: C565/76-8

CORNER NOTES

DECEMBER 2011

BY: TONY HOSTETTER
63538 PINTAIL DR.
COOS BAY, OR 97420

DOUGLAS COUNTY
SURVEYOR

FOR: WEYERHAEUSER COMPANY
98674 DELLWOOD LANE
COOS BAY, OR 97420

E 1/16 CORNER, SECTION 28 & 33, T.23 S., R.9 W., W.M.
DOUGLAS COUNTY, OREGON

FOUND: 1977 BLM BRASS CAP AS DESCRIBED PAGE 16220 DOUGLAS COUNTY RECORDS.



FROM WHICH:

22" FIR, NO MARKS VISIBLE, BT TAG,
BEARS; N 21°W, 37.6 FEET TO CENTER

NEW BTS:

8" FIR, SCRIBED "S33 1/16 BT", WEYCO TAG,
BEARS; S 27°23'E, 14.6 FEET TO SPIKE IN ROOT COLLAR.

E16 28 33-23-9.DOX

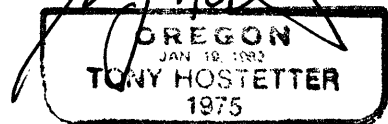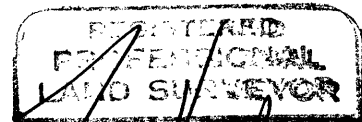

EXPIRES: 6/30/13

C.S. File No 65/76-8