

**REWITNESSED CORNER FOR
STATE OF OREGON – DEPARTMENT OF FORESTRY**

Center North 1/16 Corner Section 15, Township 22 South, Range 11 West, W.M., Douglas County, Oregon.

ESTABLISHED by A.G. Gibson, 1971

Oregon State Board of Forestry 1½" x 36" galvanized iron pipe with 3" bronze cap in mound of stone from which a;

25" Spruce N89 1/2°W 69.5 ft.; now 44" in place, face closed and bottom rotted.
6" X on 3ft. x 5ft. Sandstone face S74 3/4°E 9.0 ft.; in place.
4" x 4" x 72" White Painted Cedar Post North 1.5 ft.; now rotted and fallen over.

REWITNESSED from the above pipe and cap.

Carsonite witness post N46°E 2.75 ft. to base.
Carsonite witness post N18°W 2.20 ft. to base.

Magnetic variation set at 19° east.

Dated October 23, 2012

Rewitnessed by Tim Van Vleet under my direction.
Tim VanVleet

FILED


Order 11-27-2012 by SC
This survey consists of:
Map: _____
Narrative: _____
Corner Rpt: CS 65/77-51

DOUGLAS COUNTY
SURVEYOR

Rewitnessed By:



James M. McIntosh

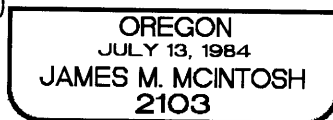

James M. McIntosh
63612 Fifth Road
Coos Bay, Oregon
Expiration date of certificate 12-31-12

Present and witnessed by Ralph C. Hall

C.S. File No 65/77-51