

FILED

Date: 7/29/2013 By: JC

This survey consists of:

Map: _____

Narrative: _____

Corner Rpt: CS 65/78-55

CORNER NOTES

JULY 2013

DOUGLAS COUNTY
SURVEYOR

BY: TONY HOSTETTER
63538 PINTAIL DR.
COOS BAY, OR 97420

FOR: MENASHA LOG CO., LLC
PO BOX 588
NORTH BEND, OR 97459

NW 1/16 CORNER, SECTION 17, T 22 S., R 11 W., W.M.
DOUGLAS COUNTY, OREGON

FOUND: BRASS CAP AS SET BY GIBSON IN 1973 (M51-28)


40" CEDAR STUMP, (GIBSON BT) NO MARKS,
BEARS; S62°30'W, 41.8 FEET.

NEW BTS:

14" HEMLOCK, SCRIBED " S17 1/16 BT",
BEARS: N 62°20'E, 17.0 FEET TO SPIKE, PLACED
BELOW FACE.

22" HEMLOCK, SCRIBED "S17 1/16 BT",
BEARS: S69°14'E, 45.2 FEET TO SPIKE, PLACED
BELOW FACE.

NW 16 17-22-11. DOX

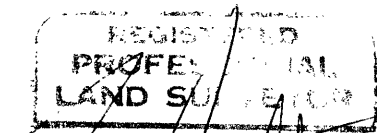

Tony Hostetter
OREGON
JAN 22 1981
TONY HOSTETTER
1975

EXPIRES: 6/30/15

C.S. File No 65/78-55