A SURVEY FOR ROME CREEK TIMBER III LLC

LOCATED IN THE SOUTH 1/2 OF SECTION 12, TOWNSHIP 30 SOUTH,
RANGE 3 WEST, WILLAMETTE MERIDIAN, DOUGLAS COUNTY, OREGON

FILED
Date: 8-12-2013 By: JC
This survey consists of:
Map: CS 65/79-12A
Narrative: ____
Corner Rpt: CS 65/79-12A-G

DOUGLAS COUNTY
SURVEYOR

NARRATIVE

THIS SURVEY MAP IS BEING FILED TO SHOW THE CONTROLLING CORNERS USED IN MARKING THE SOUTH 1/2 OF THE EAST LINE OF SECTION 12.

THE SOUTHEAST SECTION CORNER AND THE EAST 1/4 CORNER OF SECTION 12 WERE FOUND. ALSO DURING THE COURSE OF THE PROJECT, AN ORIGINAL LINE TREE WAS FOUND AND PERPETUATED AS SHOWN HEREON. THE TWO ABOVE MENTIONED CORNERS, TOGETHER WITH THIS TREE, WERE USED TO CONTROL THE MARKING OF THE BOUNDARY LINE BETWEEN THE ROME CREEK TIMBER PROPERTY AND THE PUBLIC LANDS TO THE EAST. THE RECOVERED LINE TREE MAKES AN ANGLE POINT IN THE LINE, AND THE TWO 1970 BLM CAPS ARE THEREFORE SHOWN TO BE OFF THE ORIGINAL ALIGNMENT.

LINES WERE MARKED WITH RED FLAGGING AND STEEL FENCE POSTS PAINTED RED. TREES ALONG THE PROPERTY LINE WERE BLAZED AND ALSO PAIINTED RED.

FIELD CREW: G.LANG; T.LANG
EQUIPMENT: NIKON DTM 420
MAPPING: G.LANG

LEGEND

- FOUND ORIGINAL LINE TREE
- FOUND BRASS CAP
- LINE MARKING WITH STEEL POSTS, RED FLAGGING, AND TREE BLAZES
- △ CALCULATED POINT

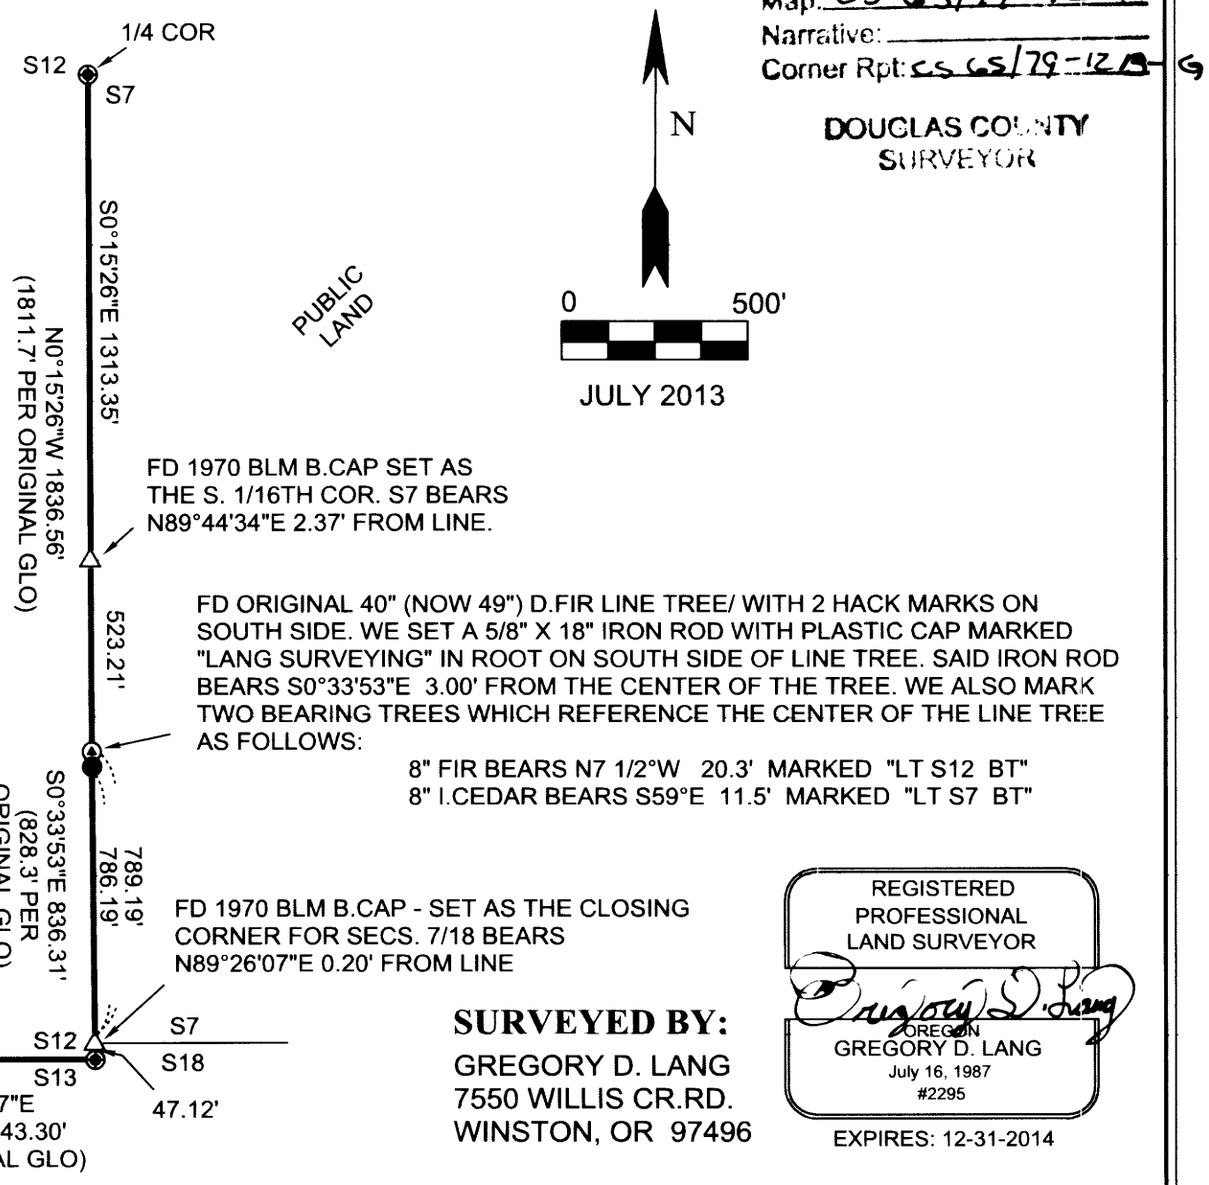

BASIS OF BEARING
PER ORIGINAL SURVEY
BY BUSHEY IN 1893

SURVEYED BY:
GREGORY D. LANG
7550 WILLIS CR.RD.
WINSTON, OR 97496

REGISTERED
PROFESSIONAL
LAND SURVEYOR
OREGON
GREGORY D. LANG
July 16, 1987
#2295

EXPIRES: 12-31-2014

Traverse PC

C.S. File No 65/79-12A