CORNER REPORT FORM

FILED

Date: 4/10/2014 By: JC

Section 10 Township 33S Range 7W
Douglas County Date 4-2014
PLSS Number 400540
~~1/4 COR~~

This survey consists of:
Map: _____
Narrative: _____
Corner Rpt: CS 65/82-27

DOUGLAS COUNTY
SURVEYOR

CORNER DESIGNATION

1/4 COR S9/S10

X Condition report only
___ Not Found
___ Renewed
___ Unrecorded
___ Surveyed In
___ Referenced out

Previous Renewals/Surveys, etc:

BLM 1981
M 98-47

Monument(s) & Accessories Found: (Condition and Source)

FD BLM BRASS CAP
38" 4 TM 11 FIR STUMP Badly Burnt N35E 13.4FT
12" Burnt PINE STUMP N39E 44.2FT
20" MADRONA N30W 86.1FT GOOD SCAR
18" FIR N47W 36.3FT GOOD SCAR

Monument Detail

Sketch

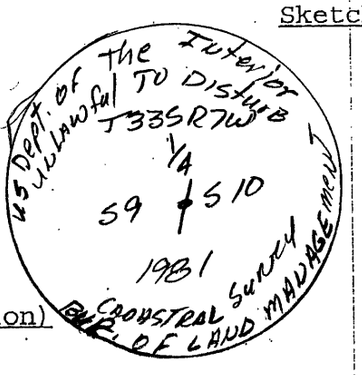

Monument Set (Procedures and Description)

New Accessories

Surveyor's Seal

Location & Comments

AREA Badly
Burnt
8-2013

Compass Declination 15½E
Firm/Agency: Leong.
Address:

Party Chief: J LEONARD
Notes:
Witness: N From dshl

REGISTERED
PROFESSIONAL
LAND SURVEYOR

OREGON
JULY 14, 1978
RONALD A. QUIMBY
1634

EXP 12-31-14

C.S. File 65/82-27