USDA-FOREST SERVICE

FILED JUL 2 2014

Index **CORNER RECORD (SEARCH)**

File No. V-15 **PROJ. NO.** ELK **CORNER** 1/4 S 34

TOWNS. 31 S **RANGE** 1 W **R.D.** TILLER **COUNTY** DOUGLAS **GCDB#** 439200

MERID. WM **FOREST** UMPQUA **STATE** OREGON

CORNER DIAGRAM

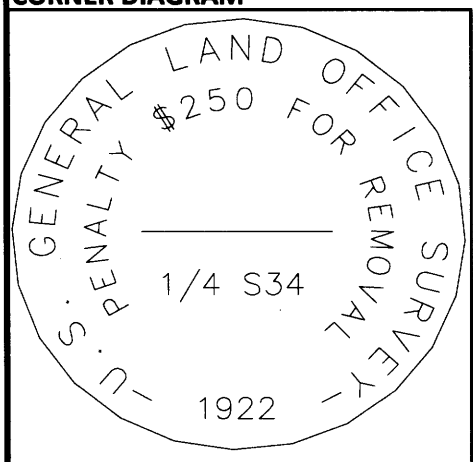

Obj. Ident.

Ident. By

Signature

PLANE COORDINATE POSITION DATA

State **Zone**

North

West

Estab. By

DESCRIBE CORNER MONUMENT FOUND

FOUND 2-1/2" BRASS CAP ON 1" IRON PIPE, PROJECTING 14 INCHES ABOVE THE GROUND. MONUMENT LEANS WEST-NORTHWEST

DESCRIBE BEARING TREES OR OTHER OFFICIAL ACCESSORIES FOUND

DIA	TYPE	BEARS	DIST	FACE/MARKINGS
33"	D.FIR	(S38°11'W)	(17.7 FT)	HEALED SINGLE HIGH BLAZE
12"	FIR STUMP	(S48°40'W)	(59.9 FT)	6.5' HIGH STUMP, ROTTEN FACE, NO BARK
2.5"	BRASS CAP	(S88°05'E)	(49.05 FT)	1/4 S27 ONLY GLO CAP PER M58-7

( ) = RECORD PER M83-4

DESCRIBE CORNER LOCATION RELATIVE TO NEAR-BY FEATURES, ALSO HOW TO REACH CORNER

CORNER FALLS ON SLIGHT WEST SLOPE, JUST SOUTH OF OLD BARBED WIRE FENCE, ON EDGE OF TIMBER LINE WITH OLD GROWTH TO THE NORTH. TO FIND CORNER, TAKE 1610-370 ABOUT 500 FT PAST THE 378 SPUR, GO SOUTH ON OLD OVERGROWN ROAD ABOVE ROCK EROSION CONTROL ON EDGE OF ROAD, FOLLOW OLD ROAD TO POSTED LINE, THEN EAST ON LINE.

Signature **Title** **Division** **Headquarters** **Date** 7100-52 (3/68)

CORNER RECORD (PERPETUATION)

REGISTERED PROFESSIONAL LAND SURVEYOR

John Ransom

OREGON JULY 21, 1992 JOHN C. RANSOM 2561

MONUMENT : DESCRIBE NEW MONUMENT SET, OR WORK DONE TO PRESERVE EXISTING MONUMENT

BRUSH CLEARED AROUND MONUMENT AND TO BT'S
"LAND LINE" FLAGGING TIED ON MONUMENT AND GUARD POSTS

ACCESSORIES : DESCRIBE NEW BT's WITNESS OBJECTS ETC. ESTABLISHED, OR WORK DONE TO PRESERVE EXISTING EVIDENCE

NO NEW ACCESSORIES ADDED
NEW NAILS IN BT TAGS AND PAINTED FACES & 6 INCH BAND AT HEAD HEIGHT

DONE BY: Jonathan Drew **TITLE** LSIT **DATE** 1/7/2013 **PLS NO./AGENCY/STATE** JOHN RANSOM, PLS2561

Certified Cor. Record Prepared ? NO **Filed At:** **DATE**

REMARKS

PROPERTY LINE MAINTINED WEST 1700 FT +/- AND EAST .5 MILE

Index File No V-15 **T.** 31 S **R.** 1 W **M.** WM **Proj No.** ELK **Cor.** 1/4 S 34

C.S. File No 65/85-21