

BT6
 COUNTY SURVEYOR'S RECORD

OF
 RE-ESTABLISHED GOVERNMENT CORNERS

Decl. Compass 17th Mo. March 10 Day 2015 Year No. Book Page

Old Monument Byars 1901 Book 47, Pg. 012

Found original corner tree; 40" Douglas Fir stump with some solid wood, 4' tall with scribes on the NE, South and West sides. We paint the scribe areas in blue.

Old Monument Powell 1967 Book 12, Pg. 09

Found 2 1/2" brass cap on a 1 1/4" o.d. iron pipe, 0.7' tall, in good condition and solid in the ground, 4.0' North of the corner tree stump. We set a Douglas Fir post 3' North of the BCIP and paint the top in blue.

The following measurements are taken from the BCIP monument:

Old BT Byars 1901 Book 47, Pg. 012

Found a 40" Douglas Fir stump, N 39° 30' E, 19.45' to heart center. We find visible scribes with a Douglas County tag in place. We paint the face and a band in blue. POOR

Old BT Byars 1901 Book 47, Pg. 012

Found a 39" Douglas Fir stump, 5' tall, N 58° W, 18.13' to heart center. We find visible scribes in a mostly healed offset blaze. We paint the face in blue. FAIR

Old BT Byars 1901 Book 47, Pg. 012

Found a 30" Douglas Fir stump, S 57° E, 36.74' to heart center. We find visible scribes with a Douglas County tag in place. We paint the face and "BT" in blue. POOR

Old BT Powell 1967 Book 12, Pg. 09

Found a 30" Hemlock, S 17° W, no distance measured. We find visible scribes in a mostly healed blaze. We paint the face and a band around the tree in blue.

Tree has rotten heart but is in FAIR CONDITION

Old BT Powell 1967 Book 12, Pg. 09

Found a 21" Chinkapin, S 19° E, 136.15' to side center. We find a healed offset blaze and tag nails in place. We paint the face and a band around the tree in blue. Tree is alone in clear cut. GOOD CONDITION

New BO

A 16" Douglas Fir low cut stump, S 82° W, 21.22' to a spike and Coos County washer driven in at heart center. We chop an "X" in the face and paint the "X" and the top of the stump in blue and attach a yellow Coos County tag.


New BO

A 23" Douglas Fir low cut stump, N 0° W, 6.02' to a spike and Coos County washer driven in at heart center. We chop an "X" in the face and paint the "X" and the top of the stump in blue and attach a yellow Coos County tag.

New BO

A 19" Douglas Fir low cut stump, S 63° E, 19.31' to a spike and Coos County washer driven in at heart center. We chop an "X" in the face and paint the "X" and the top of the stump in blue and attach a yellow Coos County tag.

Present:
 Matthew Martin
 Bill Hales

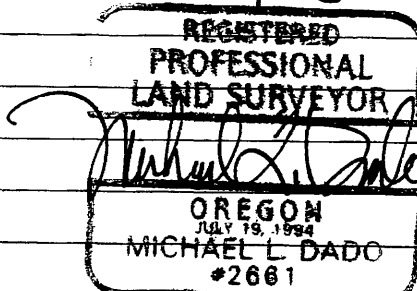

FILED
 Date: 4/28/2015 By: JC
 This survey consists of:
 Map:
 Narrative:
 Corner Rpt: CS 60/87-58

DOUGLAS COUNTY SURVEYOR