

FILED

Date: 11-3-2015 By: X

This survey consists of:

Map: _____

Narrative: _____

Corner Rpt: CS65/89-48

CORNER NOTES

May 27, 2015

BY: TONY HOSTETTER
63538 PINTAIL DR.
COOS BAY, OR 97420

DOUGLAS COUNTY
SURVEYOR

FOR: WEYERHAEUSER COMPANY
98674 DELLWOOD LANE
COOS BAY, OR 97420

ANGLE POINT ON THE SOUTH BOUNDARY OF SECTION 34, T.23 S., R.10 W., W.M.

DOUGLAS COUNTY, OREGON

FOUND: 1960 OREGON STATE BOARD OF FORESTRY BRASS CAP AS
DESCRIBED BY GIBSON, CS FILE 42/422.

FROM WHICH:

34" FIR STUMP, OBT, WEYCO TAG AND "W" NAIL,
BEARS; N78°E, 6.6 FEET TO CENTER.

30" FIR STUMP, OBT, "W" NAIL,
BEARS; S65°E, 4.6 FEET TO CENTER.


32" FIR STUMP, GIBSON BT, SCRIBING VISIBLE, TAG AND "W" NAIL,
BEARS; S85°W, 26.2 FEET TO CENTER.

NEW BTS:

11" FIR, BT TAG,
BEARS: N12°E, 3.0 FEET TO 6" SPIKE, PLACED BELOW TAG.

14" FIR, BT TAG,
BEARS: S74°W, 8.1 FEET TO 6" SPIKE, PLACED BELOW TAG.

AP 34-23-10.DOC

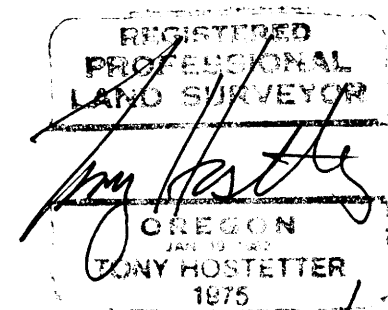

C.S. File No 65/89-48