FS INDEX ID: Z-22 & A-22

CORNER INVESTIGATION REPORT

CORNER: W 1/16
TOWNSHIP: 30S & 31S
RANGE: 2W
SECTION: 36 & 1
MERIDIAN: W.M.

GCDB ID: 620100 & 620700
STATE: OREGON
COUNTY: DOUGLAS
FOREST: UMPQUA
DISTRICT: TILLER

DATE: 7/7/2015

HISTORY OF VISITATIONS:
1978-G.S. BAUGHMAN, M65-79

NFSL PROPERTY BOUNDARY CORNER?: [x] YES [ ] NO
LINE(S) POSTED: SOUTH-1978 EAST-1978
MAINTAINED: SOUTH-2015 EAST-2015
GUARD POST(S): SOUTH-13.3FT EAST-2.6 FT

CORNER HISTORY:
(1978)-ESTABLISHED WEST 1/16 CORNER, SETS BRASS CAP/IRON PIPE & 2 BT'S.

REGISTERED PROFESSIONAL LAND SURVEYOR
OREGON
DECEMBER 3, 2014
JONATHAN B. DREW II
89396
EXPIRES: 12/31/2015

MONUMENT FOUND/SET:
FOUND A 3" BRASS CAP ON 2-1/2" GALVANIZED IRON PIPE, PROJECTING 5 INCHES ABOVE A MOUND OF STONE.

RECORD CORNER ACCESSORIES:
A 35" FIR WITH A HEALED DOUBLE BLAZE.
A 23" FIR WITH A HEALED DOUBLE BLAZE.

RECORD MEASUREMENTS:
(N17°E-12.5 FT)1978
(S71°W-55.7 FT)1978

FILED
Date: 8-25-2015 By: JC
This survey consists of:
Map:
Narrative:
Corner Rpt: CS 65 | 90-69
DOUGLAS COUNTY SURVEYOR

NEW CORNER ACCESSORIES:
NO NEW ACCESSORIES ADDED.

METHOD OF MEASUREMENT:
NO NEW MEASUREMENTS TAKEN.

FILED AS CONDITION REPORT.

CORNER MAINTENANCE/OTHER INFO:
CLEAR BRUSH FROM AROUND MONUMENT AND TO BT'S. TIE FLAGGING TO MONUMENT AND GUARD POSTS. PAINT BT FACES & A 6" BAND AT HEAD HEIGHT, ADD NEW NAILS TO EXISTING BT TAGS & ADD NEW TAGS WHERE NEEDED.

CAP DIAGRAM:

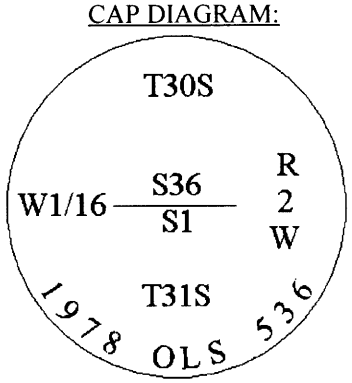

GEODETIC COORDINATES:
LATITUDE: N 42° 55' 00.061"
LONGITUDE: W 122° 53' 53.145"
ELLIPSOID HEIGHT: 2790 FT
DATUM: WGS 84
SOURCE: CELL PHONE GPS, FOR NAVIGATION TO CORNER.
DATE OF INVESTIGATION: 6/18/2015
REPORT BY: JONATHAN B. DREW II, PLS#89396, CFedS#1664
ASSISTED BY: ANDREW HILLMAN, SURVEY TECH.

DOCUMENTS ON FILE AT:
3106 PIERCE PARKWAY, STE. D
SPRINGFIELD, OREGON 97477

THIS DOCUMENT FILED IN CS OFFICE: YES
OTHER DOCUMENT FILED WITH CS: NONE

C.S. File No 65/90-69