# MAP OF SURVEY

## LOCATED in the NE 1/4 of Sec. 30, T. 21 S., R. 6 W., W.M. in Douglas County, Oregon.

## December 28, 2015

FILED
Date: 1-6-2016 By: JC
This survey consists of:
Map: CS 65/92-1
Narrative:
Number Pgs:

DOUGLAS COUNTY
SURVEYOR

**SURVEYED FOR:** *SENECA JONES TIMBER CO.*
*P.O. BOX 10265*
*EUGENE, OREGON 97401*


**SURVEYED BY:** *DAVID EDWARDS LAND SURVEYING*
*P.O. BOX 361*
*OAKLAND, OREGON 97462*
*PHONE: (541) 459-0512*


REGISTERED PROFESSIONAL LAND SURVEYOR
David A. Edwards
OREGON
JULY 26, 1988
DAVID A. EDWARDS
2339
*RENEWS 12/31/15*

## LEGEND

◉ INDICATES 1958 COUNTY SURVEYOR BRASS CAP FOUND AS PER 2013 B.L.M. RESURVEY.

● INDICATES HAINES' T-IRON FOUND AT 1/4 CORNER PER M 27-31. SEE NARRATIVE.

( ) DENOTES RECORD DATA PER M 27-31.

[ ] DENOTES RECORD DATA PER ORIGINAL G.L.O. SURVEY.

SCALE: 1" = 500'

BASIS OF BEARINGS: M 27-31 AS SHOWN AS SHOWN.

## NARRATIVE

THE PURPOSE OF THIS SURVEY IS TO MARK THAT PORTION OF NORTH LINE OF THE NE 1/4 OF SECTION 30 SHOWN AS A BOLD LINE HEREON. A RANDOM TRAVERSE WAS RUN WHICH TIED IN THE CONTROLLING CORNERS AND OFFSETS WERE THEN MADE TO THE TRUE LINE. THE LINE WAS MARKED BY BLAZING TREES ON EACH SIDE OF LINE, BY SETTING SIX FOOT STEEL POSTS ALONG THE LINE AT INTERVALS OF 200 FEET OR LESS AND BY HANGING LIBERAL AMOUNTS OF RED FLAGGING ALONG THE TRUE LINE. THE ONLY SUITABLE TREE AVAILABLE AT THE 1/4 CORNER WAS SCRIBED "1/4 S30 BT", MEASURED TO CENTER OF TREE AT ROOT CROWN AND IS SITUATED AS FOLLOWS:

A 13" DIAMETER FIR BEARS S 57° E, 22.4 FEET.

HAINES' B.T.: A 46" DIAMETER FIR WITH BARK SCRIBES VISIBLE BEARS N 54° W, 13.0 FEET.
NO SIGN OF HAINES' OTHER BEARING TREE.

A SIX FOOT STEEL POST IS SET 2 FEET N 89° E.

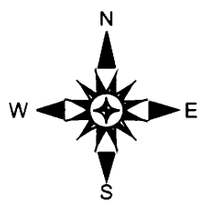


FIELD CREW: BRANT MILLER AND ERIC SPRINKLE.

EQUIPMENT: NIKON TOTAL STATION.

COMPUTATIONS AND DRAFTING: DAVID EDWARDS.

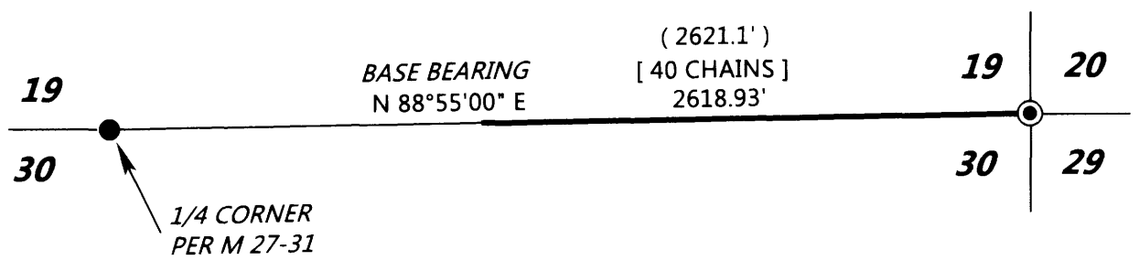


Traverse PC

C.S. File No 65/92-1