MAP OF SURVEY

LOCATED in the NE 1/4 of Sec. 18, T. 24 S., R. 6 W., W.M. in Douglas County, Oregon.

July 14, 2016

FILED
Date: 7/21/2016 By: JC
This survey consists of:
Map: CS 65/92-14
Narrative: ____
Corner Rpt: ____
DOUGLAS COUNTY
SURVEYOR

SURVEYED FOR: *ROSEBURG RESOURCES COMPANY*
P.O. BOX 1088
ROSEBURG, OREGON 97470

SURVEYED BY: *DAVID EDWARDS LAND SURVEYING*
P.O. BOX 361
OAKLAND, OREGON 97462
PHONE: (541) 459-0512

REGISTERED PROFESSIONAL LAND SURVEYOR
David A. Edwards
OREGON
JULY 26, 1988
DAVID A. EDWARDS
2339
RENEWS 12/31/17

LEGEND

◉ INDICATES B.L.M. OR COUNTY SURVEYOR BRASS CAPPED IRON PIPE FOUND.

( ) DENOTES RECORD DATA PER 1891 G.L.O. SURVEY. SCALE: 1" = 500'

BASIS OF BEARINGS: ORIGINAL 1891 GENERAL LAND OFFICE SURVEY AS SHOWN.

NARRATIVE

THE PURPOSE OF THIS SURVEY IS TO MARK THE NORTH LINE OF THE NORTHEAST QUARTER OF SECTION 18. A RANDOM TRAVERSE WAS RUN BETWEEN THE CONTROLLING CORNERS AND OFFSETS WERE THEN MADE TO THE TRUE LINE. THE LINE WAS MARKED BY BLAZING TREES ON EACH SIDE OF LINE, BY SETTING SIX FOOT STEEL POSTS ALONG THE LINE AT INTERVALS OF 200 FEET OR LESS AND BY HANGING LIBERAL AMOUNTS OF RED FLAGGING ALONG THE TRUE LINE.

FIELD CREW: BRANT MILLER AND ERIC SPRINKLE.

EQUIPMENT: NIKON TOTAL STATION.

COMPUTATIONS AND DRAFTING: DAVID EDWARDS.

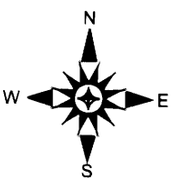

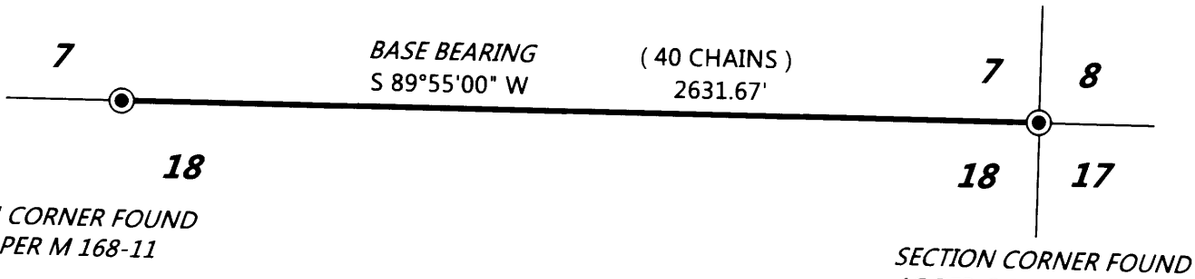

1/4 CORNER FOUND AS PER M 168-11

SECTION CORNER FOUND AS PER C.S. 65/69-24

Traverse PC

C.S. File No 65/92-14