FILED
Date: 1-12-2017 By: JC
This survey consists of:
Map:
Narrative:
Corner Rpt: CS 65/95-5

DOUGLAS COUNTY
SURVEYOR

FORM 771 10/95 DHW

PUBLIC LAND CORNER

INDEX NO. _____

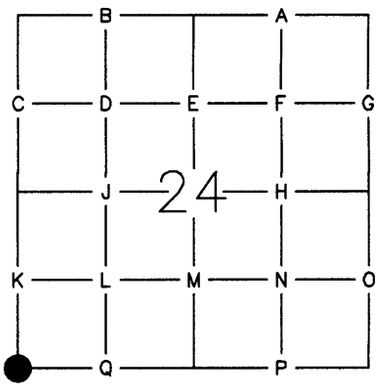

WEYERHAEUSER COMPANY

WILLAMETTE REGION

TOWNSHIP 23S RANGE 4W

SECTION 24 CORNER SOUTHWEST

COUNTY DOUGLAS OREGON

ORIGINAL CORNER DATED: 1884 BY: WILLIAM WRIGHT – GLO
CORNER: 4 FOOT POST AND MARKED STONE
ACCESSORIES: 50" FIR, N 25° W, 7 LKS. / 8" CEDAR, N 22°E, 47 LKS.
36" FIR, S 53° E, 63 LKS. / 36" FIR, S 15° W, 54 LKS.
REESTABLISHMENT NOTES DATED: UNKNOWN BY: WILFORD HAINES–CS FILE 54/16–23
EVIDENCE RECOVERED: 50" FIR SNAG, N 25° W, 7 LKS.–NO SCRIBE VISIBLE
8" CEDAR, N 22° E, 47 LKS.–SCRIBE SHOWS/ 36" FIR, S 53° E, 63 LKS.–DOWN
36" FIR, S 15° W, 54 LKS.–DOWN
CORNER SET: "T" IRON
ACCESSORIES ESTABLISHED: 26" CEDAR, S 28° E, 11.6' / 6" CEDAR, S 44° W, 20.3'
14" CEDAR, N 70° W, 49.5'

REESTABLISHMENT NOTES DATED: 1963 BY: WEYERHAEUSER COMPANY–CS FILE 53/108
EVIDENCE RECOVERED: STONE NOT FOUND BUT HAINES "T" IRON UNDER LARGE WINDFALL
8" CEDAR, N 22° E, 31.0'–GOOD SCRIBING / 36" FIR, S 53° E, 41.6'–WINDFALL
36" FIR, S 15° W, 35.6 FEET–ROTTED BROKEN STUMP / 56" FIR SNAG, N 25° W, 4.6'
26" CEDAR, S 27° E, 10.5' TO "W" NAIL / 6" CEDAR, S 44° W, 20.0' TO "W" NAIL
12" CEDAR, N 68° W, 48.7' TO "W" NAIL / 14" CEDAR, N 21° E, 30.0' TO "W" NAIL–(OBT)
CORNER SET: NOTHING

REESTABLISHMENT NOTES DATED: 1981–1982 BY: JAMES JELLY–BLM CADASTRAL SURVEY
EVIDENCE RECOVERED: HAINES "T" IRON AND WASHER
25" CEDAR, N 22° E, 47 LKS. / 36" FIR ROOTHOLE, S 53° E, 63 LKS.
FIR STUMP, S 15° W, 54 LKS. / 72" FIR STUMP, N 25° W, 11 LKS.
34" CEDAR, S 27° E, 17 LKS (HAINES) / 15" CEDAR, S 44° W, 30 LKS.
27" CEDAR, N 70° W, 75 LKS.
CORNER SET: 2 1/2" IRON POST AND BRASS CAP "1981"
ACCESSORIES ESTABLISHED: NONE

REESTABLISHMENT NOTES DATED: 2007 BY: AL SKEESICK–BLM CADASTRAL SURVEY
EVIDENCE RECOVERED: 2 1/2" IRON POST AND BRASS CAP "1981"
SAME AS 1981 BLM SURVEY
ACCESSORIES ESTABLISHED: 11" FIR, N 80 3/4° W, 32.3 FEET

REMONUMENTATION

DATE: 2/2008 BY: DANIEL W. BAKER TITLE: PLS 1978 FIRM: BAKER & ASSOC.
EVIDENCE RECOVERED: 3 1/4" BRASS CAP "1981"
35" CEDAR, N21°E, 31.4' TO CENTER / 42" CEDAR, S30°E, 10.1' TO CENTER
59" FIR ROOTHOLE, S53°E, 65.2' TO CENTER / ROTTEN FIR STUMP, S15°W, 38.6' TO CENTER
28" CEDAR, S46°W, 20.3' TO CENTER / 11" FIR, N78°W, 32.3' TO CENTER
27" CEDAR SNAG, N71°W, 49.3' TO CENTER / 64" FIR STUMP, N30°W, 7.7' TO CENTER

CORNER SET: NONE
ACCESSORIES ESTABLISHED: NONE
OTHER INFORMATION: 6 FOOT METAL POST ALONGSIDE CORNER

C.S. File No 65/95-5