MAP OF SURVEY

LOCATED in the SE 1/4 of Sec. 26, T. 21 S., R. 6 W., W.M. in Douglas County, Oregon.

December 11, 2017

FILED
Date: 12/21/2017 By: JC
This survey consists of:
Map CS 65/97-7
No.
Comments:
DOUGLAS COUNTY SURVEYOR

SURVEYED FOR: *SENECA JONES TIMBER COMPANY*
P.O. BOX 10265
EUGENE, OREGON 97401

SURVEYED BY: *DAVID EDWARDS LAND SURVEYING*
P.O. BOX 361
OAKLAND, OREGON 97462
PHONE: (541) 459-0512

REGISTERED PROFESSIONAL LAND SURVEYOR
David A. Edwards
OREGON
JULY 26, 1988
DAVID A. EDWARDS
2339
RENEWS 12/31/17

LEGEND

◉ INDICATES HAINES "T-IRON" FOUND IN POOR CONDITION AND REPLACED WITH A 5/8" X 30" STEEL REBAR WITH 2 1/2" DIAM. ALUM. CAP STAMPED AS PER THE 2009 B.L.M. MANUAL AND ALSO STAMPED "L.S. 2339" AND "2017".

( ) DENOTES RECORD DATA PER M 8-30 UNLESS NOTED OTHERWISE.

BASIS OF BEARINGS: M 8-30 AS SHOWN. SCALE: 1" = 500'

NARRATIVE

THE PURPOSE OF THIS SURVEY IS TO MARK THE SOUTH LINE OF THE SE QUARTER OF SECTION 26. A RANDOM TRAVERSE WAS RUN BETWEEN THE TWO CONTROLLING CORNERS SET BY HAINES ON M 8-30. OFFSETS WERE THEN MADE TO THE TRUE LINE. THE LINE WAS MARKED BY BLAZING TREES ON EACH SIDE OF LINE, BY SETTING SIX FOOT STEEL POSTS ALONG THE LINE AT INTERVALS OF 200 FEET OR LESS AND BY HANGING LIBERAL AMOUNTS OF RED FLAGGING ALONG THE TRUE LINE. WE SEARCHED FOR BUT DID NOT FIND HAINES' EAST 1/16 CORNER.

FIELD CREW: BRANT MILLER AND ERIC SPRINKLE.

EQUIPMENT: NIKON TOTAL STATION.

COMPUTATIONS AND DRAFTING: DAVID EDWARDS.

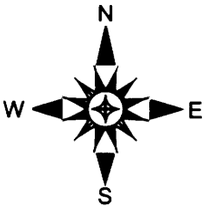

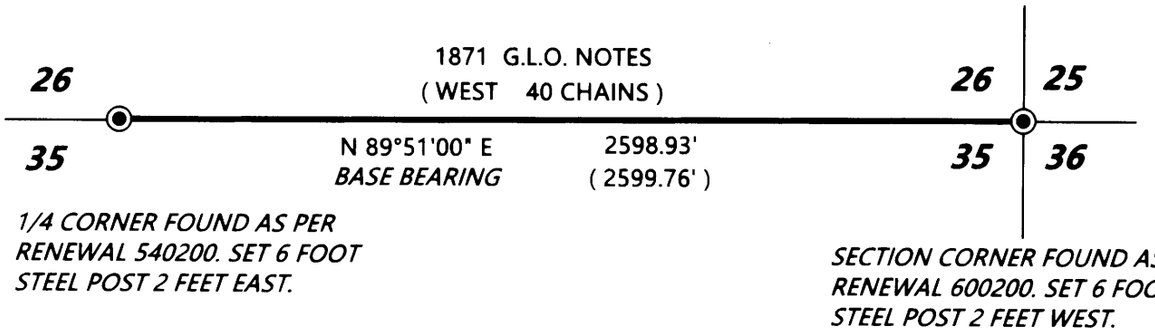

1/4 CORNER FOUND AS PER RENEWAL 540200. SET 6 FOOT STEEL POST 2 FEET EAST.

SECTION CORNER FOUND AS PER RENEWAL 600200. SET 6 FOOT STEEL POST 2 FEET WEST.

Traverse PC

CS FILE 65/97-7