RETRACEMENT LAND SURVEY PLAT and NARRATIVE

In SEC. 1, T. 33 S., R. 7 W., SEC. 36, T. 32 S. R. 7 W., and SEC. 31,T. 32 S., R. 6 W., W.M., Douglas County, Oregon

Dates: Sept. 7 to Oct. 11, 2018

FILED
Date: 11-7-18 By: BJ
This survey consists of:
Map: CS 65/98-11
Narrative:
Corner Rpt:
DOUGLAS COUNTY SURVEYOR

Survey for: Tal and Jo Blankenship
P.O. Box 909, Glendale, Or 97442
and
Shane Waltz
2614 Mt. Reuben Rd., Glendale, Or 97442

Survey by: Ronald A. Brandt LS 841
P.O. BOX 427
GLENDALE, OR. 97442
LICENSE EXPIRATION DATE: 12-31-2019

REGISTERED PROFESSIONAL LAND SURVEYOR
Ronald A. Brandt
OREGON
JULY 12, 1968
RONALD A. BRANDT
841

SURVEYOR OFFICE REFERENCES:
Survey CS 55/2
Survey M78-48
Survey CS 58/125N
Survey M136-55 (basis-of-bearing)
1963 and 1968 BLM Resurveys

DEED RECORDS:
Volume 375, Page 352
Volume 379, Page 383
Volume 513, Page 513
Volume 253, Page 874
Book 1042, Pages 811-812

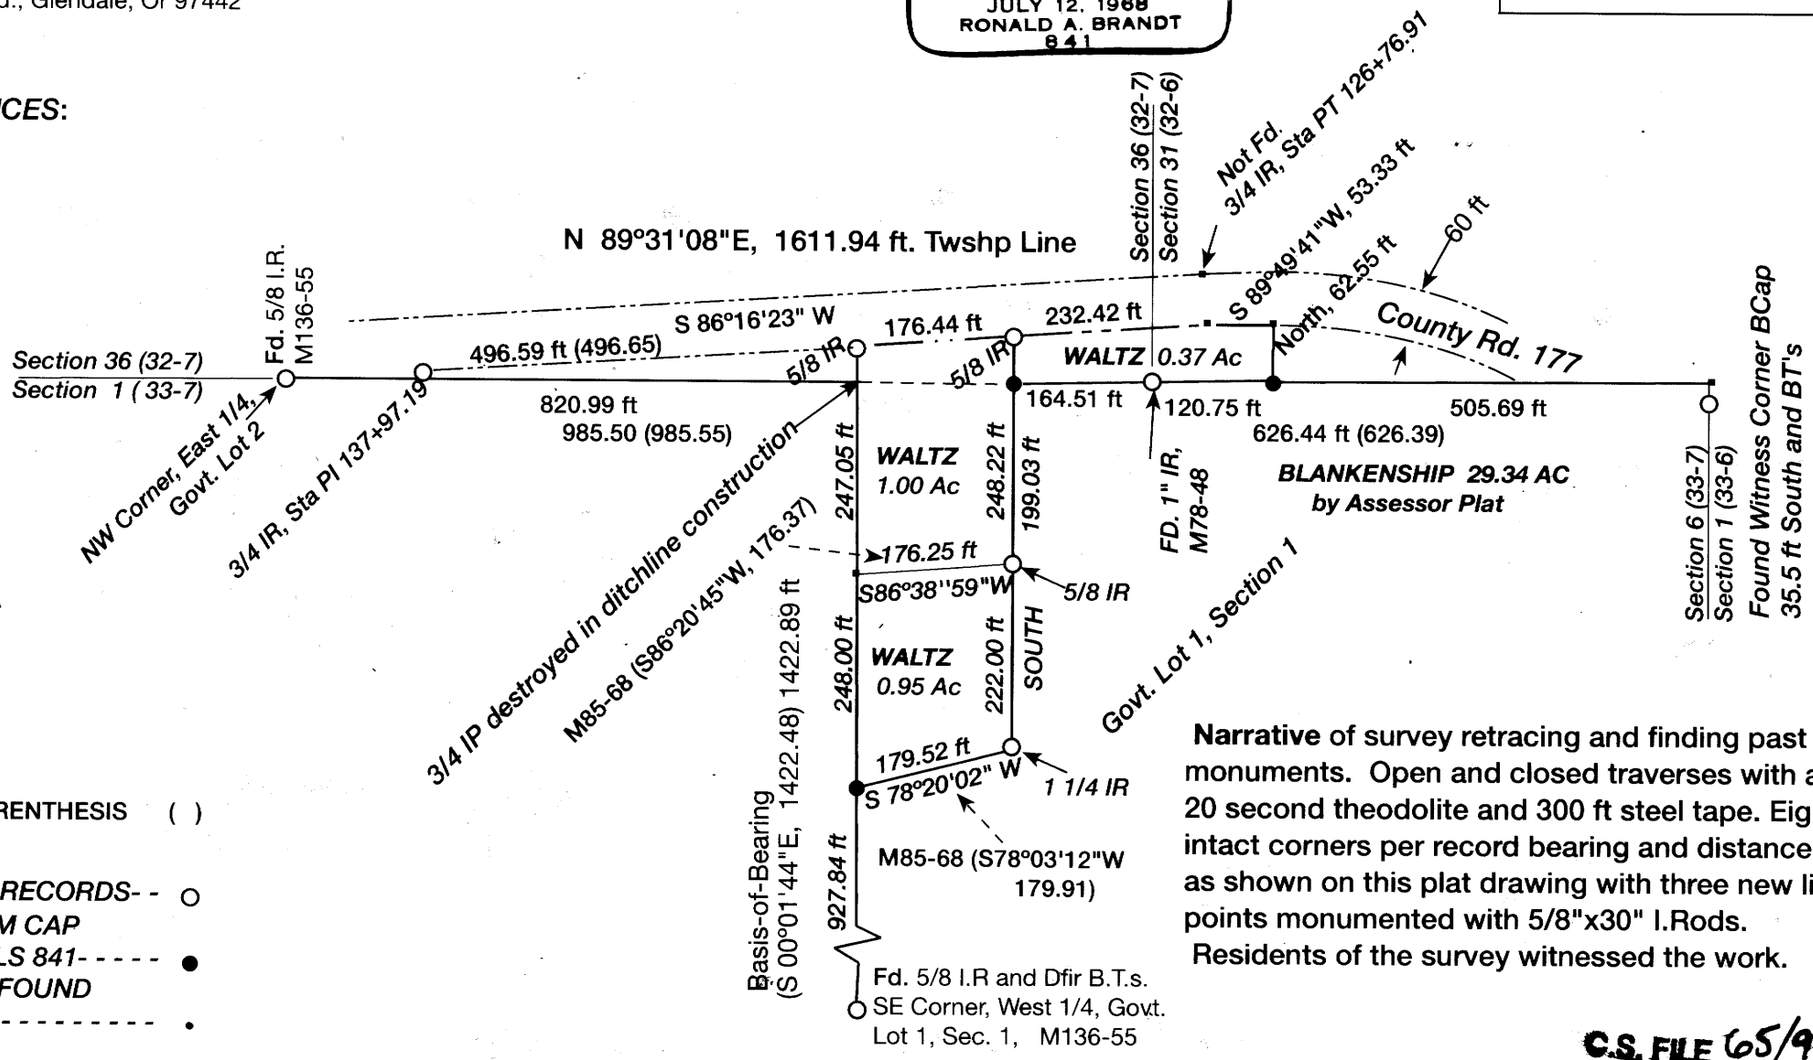

LEGEND:

SCALE: 1 Inch = 200 Feet

N

RECORD OF SURVEY M136-55 , PARENTHESIS ( )

Monuments:

Found- AS NOTED, INTACT PER RECORDS- - ○
SET- 5/8"X30" I RODS, ALUMINUM CAP MARKED PROP. CORNER, LS 841- - - - - ●
POINT- NOT SET, SURVEYED OR FOUND UNLESS NOTED- - - - - - - - - - - - - •

Narrative of survey retracing and finding past survey monuments. Open and closed traverses with a Jena 20 second theodolite and 300 ft steel tape. Eight intact corners per record bearing and distance found as shown on this plat drawing with three new line points monumented with 5/8"x30" I.Rods. Residents of the survey witnessed the work.

C.S. FILE 65/98-11