FILED
Date: 1-18-2018 By: X
This survey consists of:
Map:
Narrative:
Corner Rpt: CS 65/99-41
DOUGLAS COUNTY SURVEYOR

CORNER REPORT FORM

Section 514 Township 31S Range 7W
Douglas County Date 12-2017
PLSS Number 500440

CORNER DESIGNATION

1/4 515/514

- ☐ Condition Report only
- ☐ Not Found
- ☒ Renewed
- ☐ Unrecorded
- ☐ Surveyed In
- ☐ Referenced out

Previous Renewals/Surveys, etc:

KERR ENG #2125 1951 CS 40/344
DCSO 1970 CS 54/36-19

Monument(s) & Accessories Found: (Condition and Source)

2½" DCSO BRASS CAP
32" FIR N3L°W 13.9 FT GOOD SCAR
BURNT STUMP S30E 19.5 FT
BURNT STOB S51E 33.4

Monument Detail

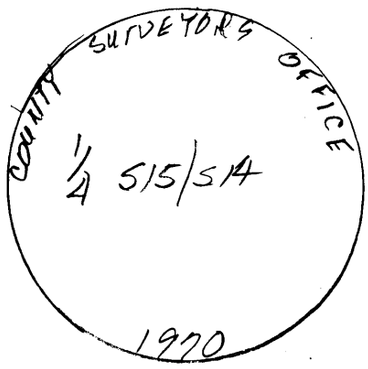

Sketch

Monument Set (Procedures and Description)

New Accessories

6" FIR	S65°E	32.2 FT	Scribed 1/4 514 BT
7" FIR	59°E	46.5 FT	Scribed 1/4 514 BT
12" FIR	S18°W	47.2 FT	Scribed 1/4 515 BT

Surveyor's Seal

Location & Comments

Corner is on South Slope is approx 20 FT North of Creek Flows Westerly & 90' EAST OF SMALL Creek Flows Southerly AREA Badly burnt 9-2017

Compass Declination 15½°E
Firm/Agency: i.e. Engineering, Inc.
Address: 809 SE Pine St., Roseburg, OR 97470
Party Chief: J LEONARD
Notes:
Witness: R OLSEN

REGISTERED PROFESSIONAL LAND SURVEYOR
OREGON
JULY 14, 1978
RONALD A. QUIMBY
1054
EXP 12-31-18

C.S. File 65/99-41