

CORNER REPORT FORM

Section 4 Township 21S Range 10W
Douglas County Date 4-30-18
PLSS Number 340660

CORNER DESIGNATION

C-N 1/16

Previous Renewals/Surveys, etc:

M 91-24

Monument(s) & Accessories Found: (Condition and Source)

FND 2 1/2" Brass cap 40 0 2 Above Ground Marked
By 1/2" Rebar with Boundary Tag per C.S. M91-24

Monument Detail

Found Bearing tree stump's
16" Fir stump N 9° E 21' 6" Rotten Painted
30" Fir stump N 42° W 21' 2" Rotten Painted

Sketch

Monument Set (Procedures and Description)


New Accessories

Bearing trees
9" Fir Bears S 25° E 9' 1" Tagged, Faced, Nail side center
12" Fir Bears N 84° W 14' 2" Tagged, Faced, Nail side center

> Tagged and blazed

Location & Comments

Compass Declination 14°
Firm/Agency: Stuntzner ENR & Forestry
Address: Po Box 118
Coos Bay OR 97420
Party Chief: Danny Dean
Notes: Ashley Miller
Witness: _____

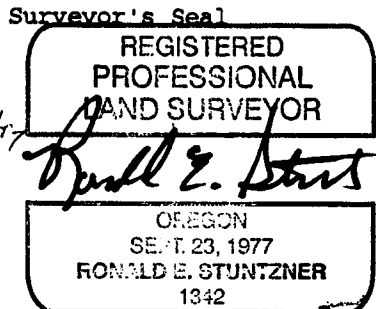

RENEWS:

C.S. File 65/101-46

FILED
Date: 7/18/2018 By: SC
This survey consists of:
Map: _____
Narrative: _____
Corner Rpt: C.S. 65/101-46
DOUGLAS COUNTY
SURVEYOR

- Condition Report only
- Not Found
- Renewed
- Unrecorded
- Surveyed In
- Referenced out