FILED

Date: 4-9-2019 By: X

This survey consists of:

Map: _____

Narrative: _____

Corner Rpt: CS 65/102-14

DOUGLAS COUNTY SURVEYOR

CORNER REPORT FORM

Section 16 Township 30S Range 3W

Douglas County Date 3/2019

PLSS Number 300440

CORNER DESIGNATION

1/4 COR S17/S16

- [ ] Condition Report only
- [ ] Not Found
- [x] Renewed
- [ ] Unrecorded
- [ ] Surveyed In
- [ ] Referenced out

Previous Renewals/Surveys, etc:

DCSO 1964 CS 52/138 LANG. 2007 M152-13

LANG 2004 CS 65/52-14A KLEIN-KITZ sept 2014 MILL-45A-E

Monument(s) & Accessories Found: (Condition and Source)

DCSO BRASS CAP

22" CEDAR N16½°E 64.4FT GOOD SCAR

15" FIR S83½°E 34.9 FT GOOD SCAR

19" FIR SNAG S10½°W 56.2 FT GOOD SCAR

14" FIR N 23°W 12.8 FT GOOD SCAR

18" FIR STUMP N77°W ~~7.8~~ 21.5 FT GOOD SCAR

Monument Detail

Sketch

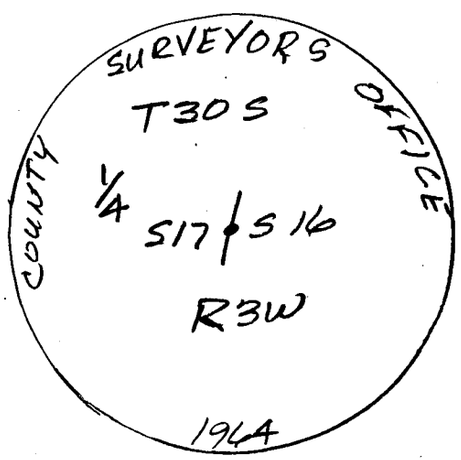

Monument Set (Procedures and Description)

New Accessories

22" D.FIR S3°W 26.3 FT Scribed 1/4 S17 BT

Surveyor's Seal

Location & Comments

CORNER IS @ TIMBER CORNER NORTHEAST APPROX. 25' EAST OF GRAVEL ROAD RUNS N.W & 250' NORTH OF SAME ROAD WHERE IT GOES EAST

Compass Declination 15½°E

Firm/Agency: i.e. Engineering, Inc.

Address: 809 SE Pine St., Roseburg, OR 97470

Party Chief: M. FROMDAHL

Notes:

Witness: R. VINCENT

REGISTERED PROFESSIONAL LAND SURVEYOR

OREGON
JULY 14, 1978
RONALD A. QUIMBY
1654

EXP 12-31-20

C.S. File 65/102-14