


Filed 8/20/2019

CORNERS FOUND O.K.
Sec 4 T23S R8W


Sec COR $\frac{5}{8} | \frac{4}{9}$ Per PLSS
300600

LINE TREE $\frac{5}{4}$
PER CS 300628

8/2019

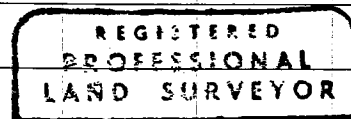

Ronald A. Quimby

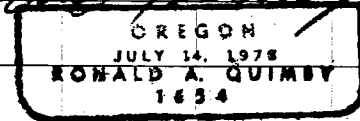

EXP 12-31-20

CS 65/102-73