

RENEWAL

Monument Detail

Monument Set (Procedure and Description)

SET A 5/8" BY 32" LONG IRON ROD
 WITH DCSO ALUM CAP AT
 POSITION OF CORNER DETERMINED
 FROM EVIDENCE OF PAST RENEWALS
 I.R. SET FLUSH WITH GROUND.

DCSO BC/IP W/IT CORNER BEARS EAST 110.0 FT
 AGREES WITH 1964 RECORD

10" NOW 19" W. OAK BEARS S34°W 81.0 FT
 AGREES WITH 1926 RECORD

NE COR CONCRETE QUONSET HUT
 BEARS N79 1/4°W 131.0 FT
 (REC. N78°W 131.0 FT) 1958

N/A

New Accessories

FROM WIT. COR. BC/IP

NE CORNER OF A METAL BUILDING BEARS S54 1/2°W, 73.7 FT

22" W. OAK SINGLE BLAZED LOW, "WC. BT" FACES DCSO BC/IP
 BEARS N15°W 68.5 FT

Sketch of Monument, Accessories, and General Area

Location & Comments

NOTE: IN NEAR FUTURE
NEW CONSTRUCTION
MAY OCCURE.

Comp. Declin. 17 3/4° E
 Agency DCSO
 Party Chief RANDALL W. SMITH
 Notekeeper [Signature]
 Witnesses STEPHEN J. FLAISE

Address



Surveyor's Seal

REGISTERED
 PROFESSIONAL
 LAND SURVEYOR

[Signature]
JULY 6-30-98

OREGON
 JULY 25, 1990
 RANDALL W. SMITH
 2489

CS 66/2-176

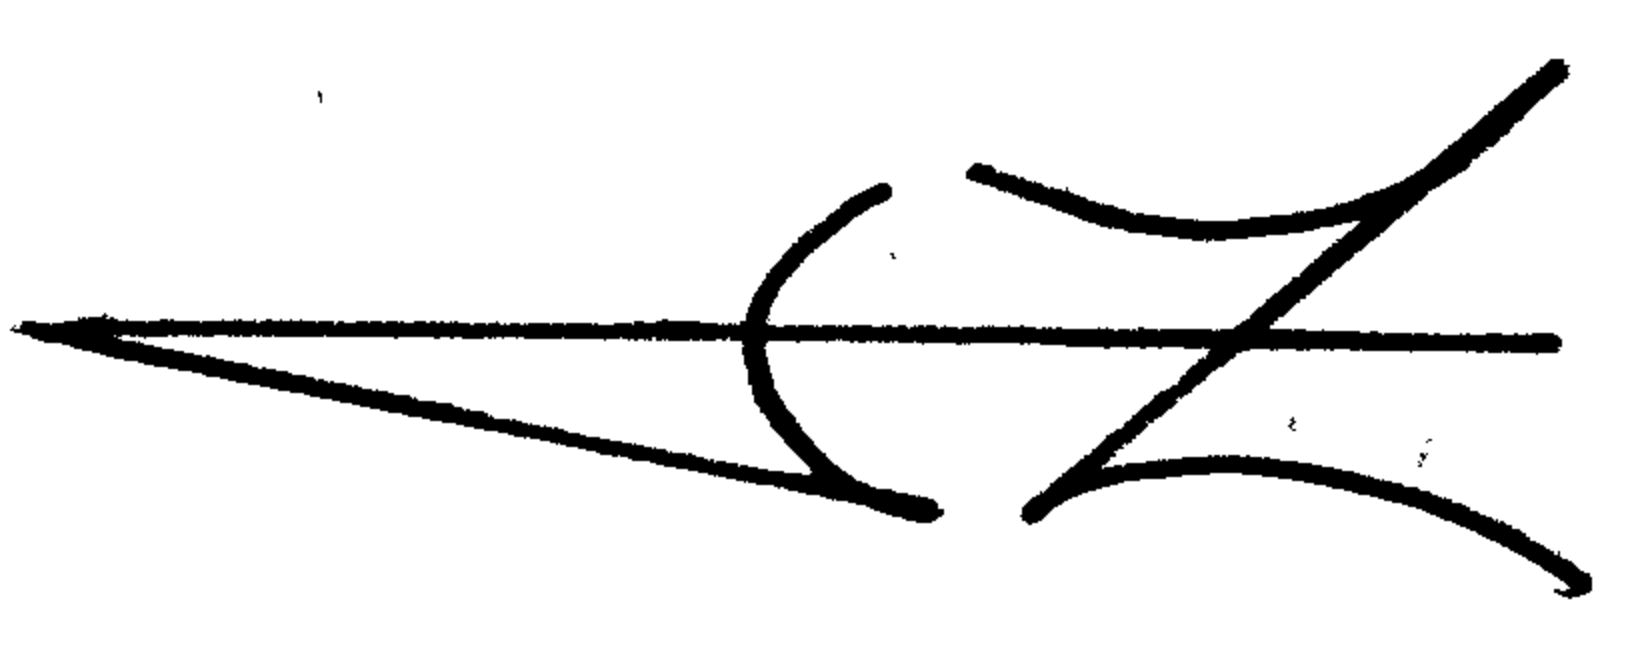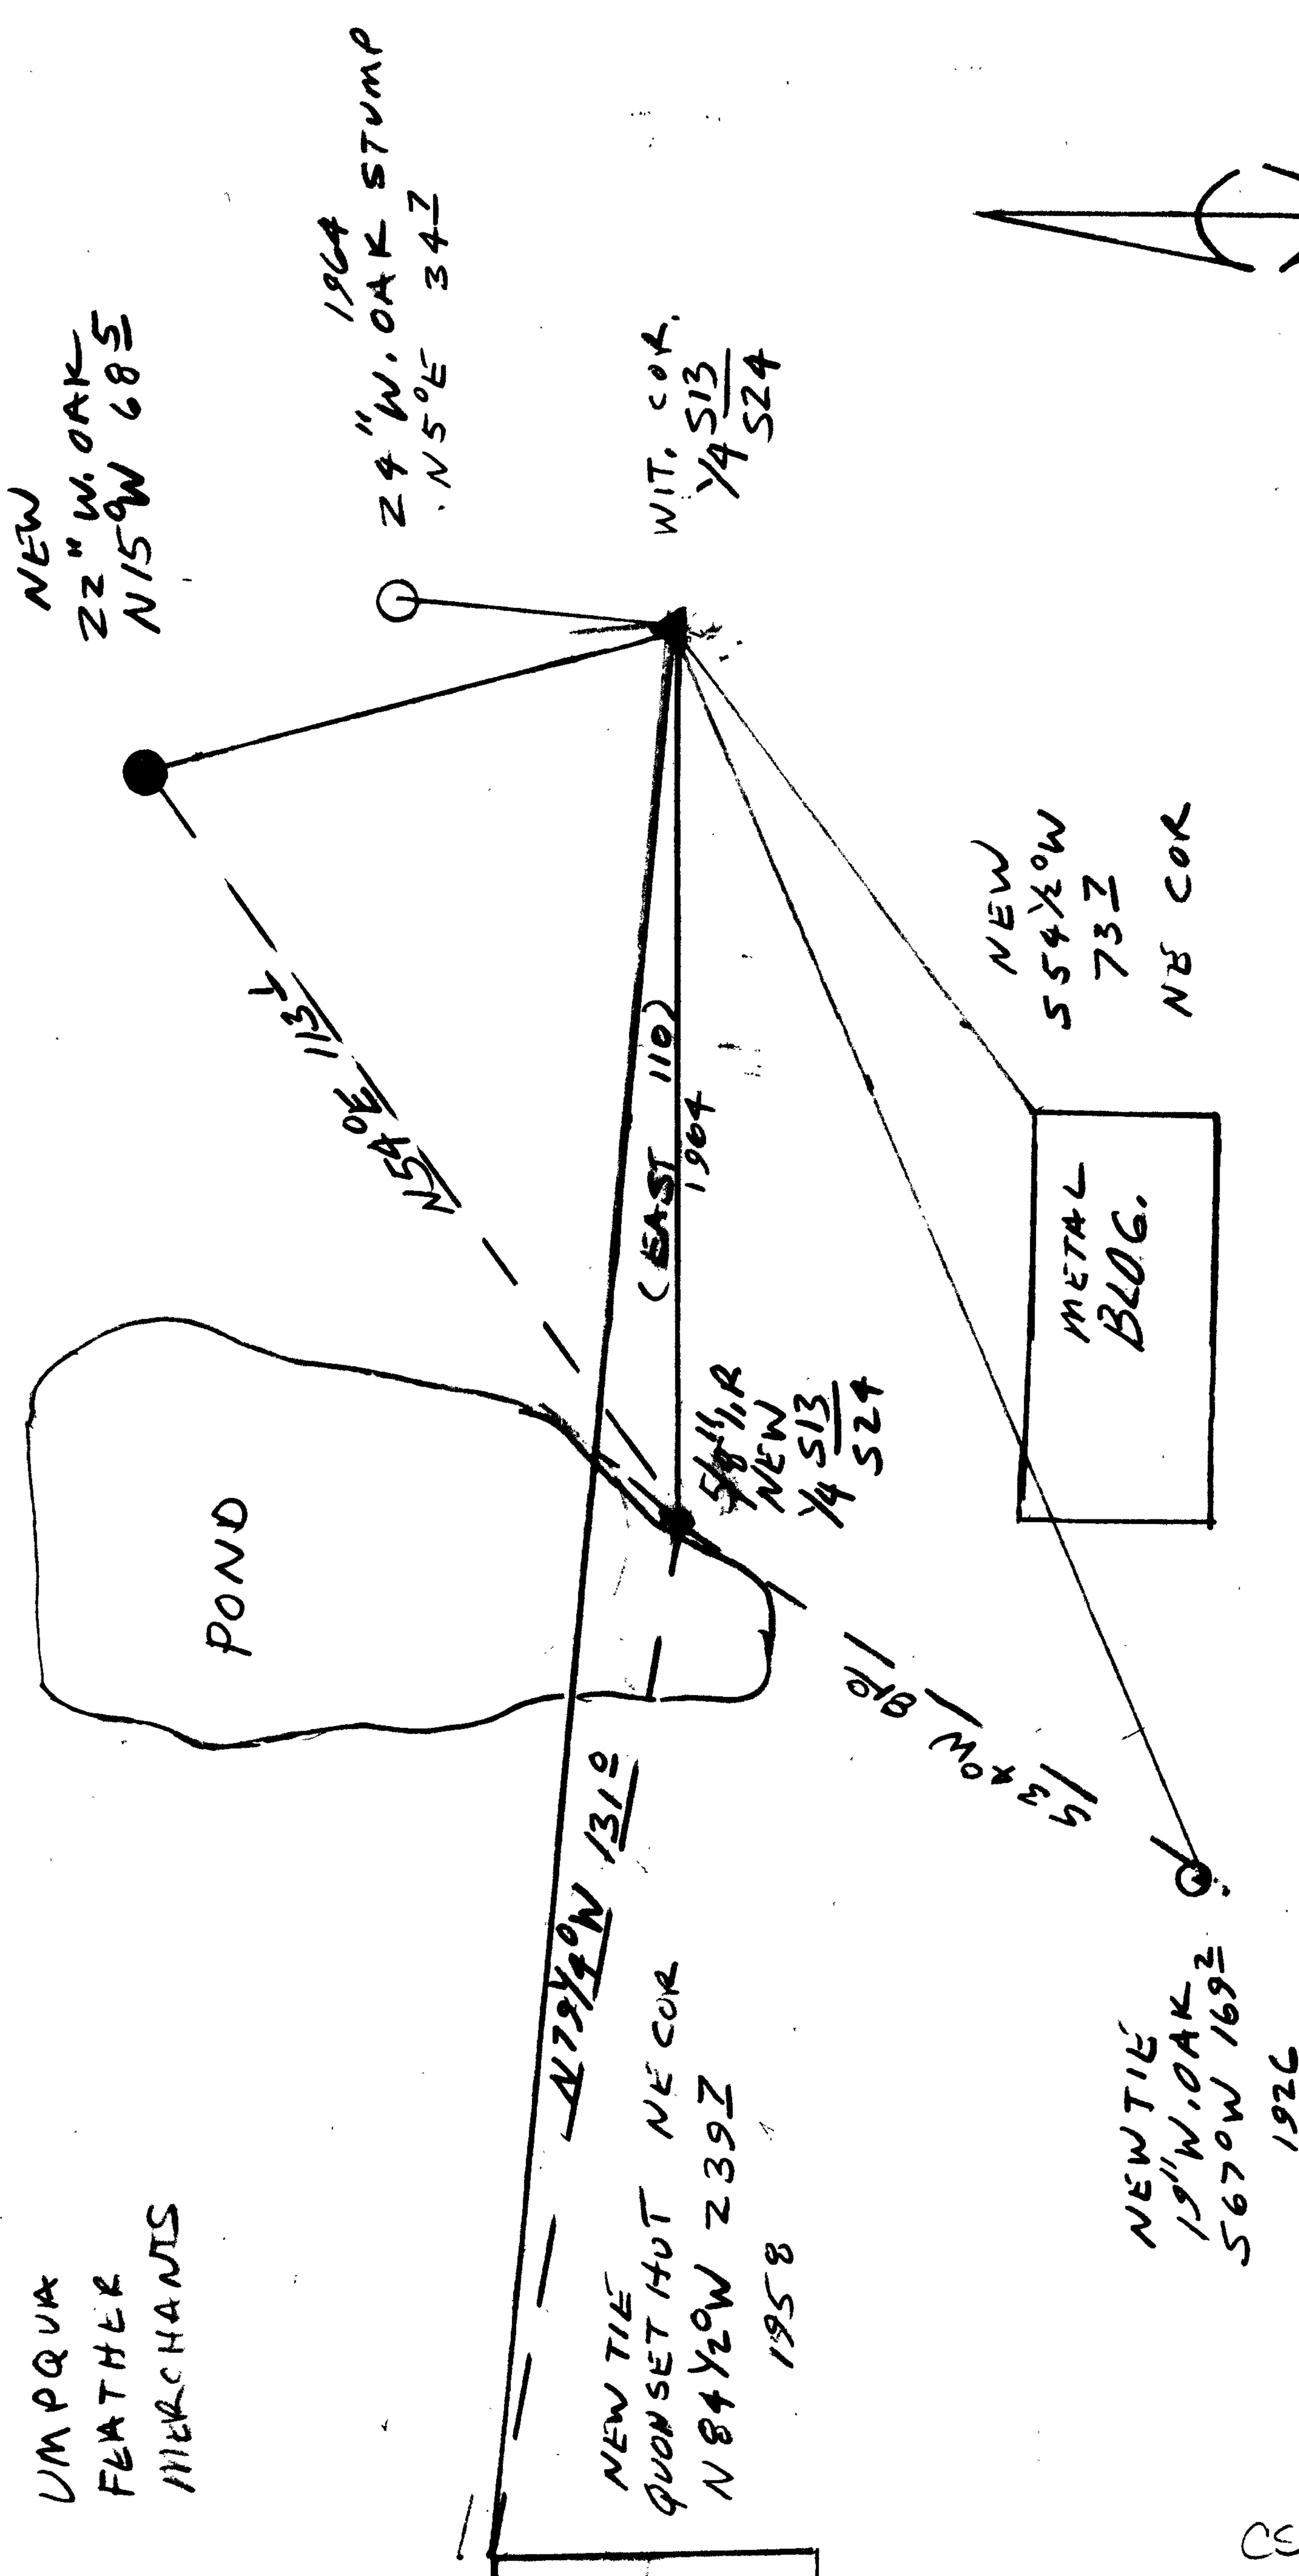

UMPQUA
 FEATHER
 MERCHANTS