R

FILED

GOVERNMENT CORNER RESTORATION FORM

Date: 6/2/1998 By: [illegible]

This survey consists of:
Map:
Narrative:
Corner Rpt: 66/2-43

Township 28S Range 7W Sec. 6 County DOUGLAS

State OR Date 5-28-98 No.

Corner Designation

AP
NORTH LINE
SEC. 6

DOUGLAS COUNTY
SURVEYOR

Condition
Not Found
✓ Renewed
Unrecorded
Surveyed In
Referenced Out

Previous Renewals 1924 GLO, 1961 DCSO

Monument(s) Found: (Condition and Source)
2½" DIA. BRASS CAP ON A 1" O.D. IRON PIPE, PROTRUDES 10" ABOVE GROUND 1924

MONUMENT DETAIL

U.S. GENERAL LAND

AP
1924

OFFICE SURVEY

Accessories Found:

8" NOW 28" DIA PINE WITH A FULLY HEALED BLAZE BEARS S 40½°E, 34.7 FT (AGREES WITH REC.) / 1961

7" NOW 18" DIA D.FIR WITH A FULLY HEALED DOUBLE BLAZE, BEARS N 4°W, 41.0 FT (AGREES WITH REC.) 1961

15" NOW 20" DIA 3½ FT HIGH ROTTED D.FIR STUMP WITH A PREVIOUSLY OPENED BLAZE NO SCRIBING VISIBLE, BEARS N 50°E 37.0 FT TO BLAZE (AGREES WITH REC.) OBT

4" NOW OLD ROTTED MADRONE WITH NEWER SPRUTS AT RECORD " N 45°W 3.3 FT " OBT

24" NOW 28" DIA 1½ FT HIGH D.FIR STUMP, NO MARKS VISIBLE, BEARS S 7°W, 11.2 FT (AGREES WITH REC. AS A BLAZE DISTANCE) 1924

172700.017 902030.012 C

C.S. File No. 66/2-43

RENEWAL

Monument Set (Procedure and Description)

NONE

Monument Detail

N/A

New Accessories

13" DIA B.OAK DOUBLE BLAZED AND SCRIBED "AP CS BT"
BEAR N 52° E, 52.6 FT

14" DIA. G. FIR DOUBLE BLAZED AND SCRIBED "AP CS BT"
BEARS S 76° W, 15.0 FT

Sketch of Monument, Acessories, and General Area

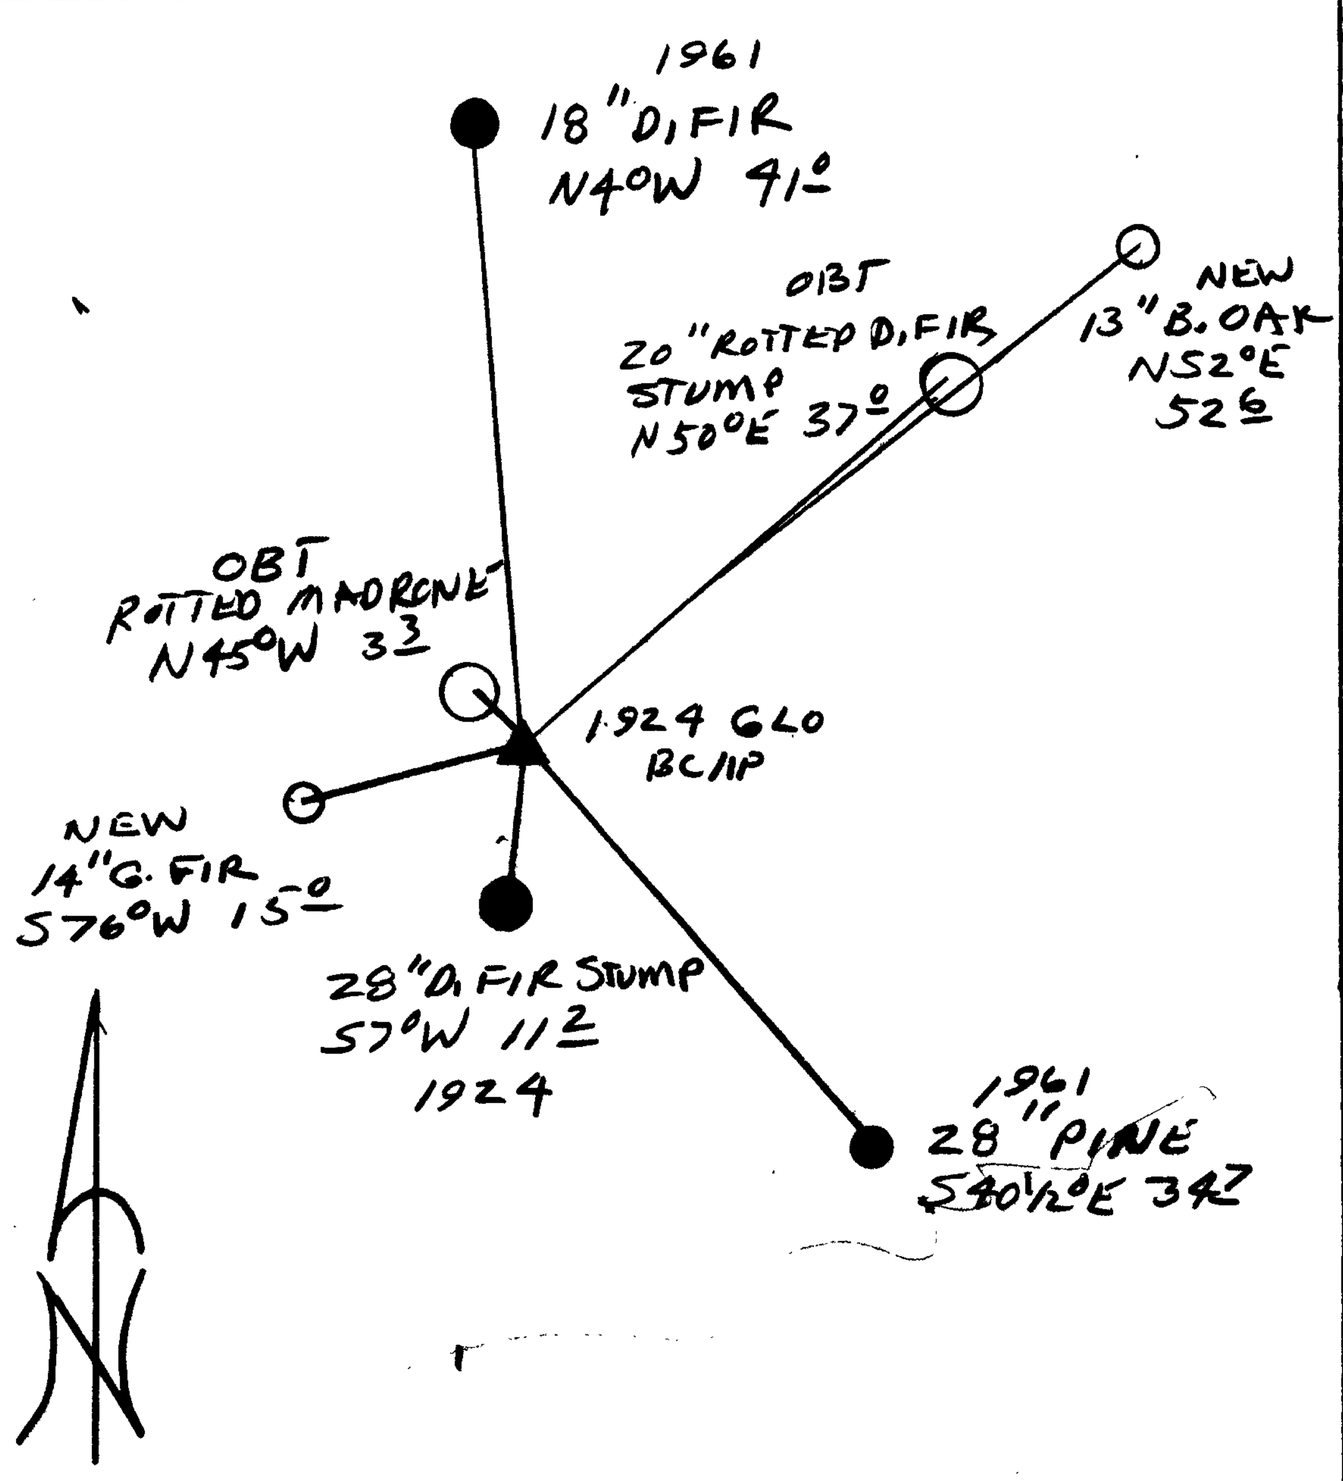

Location & Comments

Comp. Declin. 17 3/4 °E
Agency DCS
Party Chief RANDALL W SMITH
Notekeeper [illegible]
Witnesses STEPHEN T FLANSE

Address

Surveyor's Seal

REGISTERED
PROFESSIONAL
LAND SURVEYOR

EXPIRES 6-30-98

OREGON
JULY 25, 1980
RANDALL W. SMITH
2469