SURVEY FOR

DOUGLAS COUNTY LAND DEPT.

IN

SECTION 8 T 21 S R 11 W WM

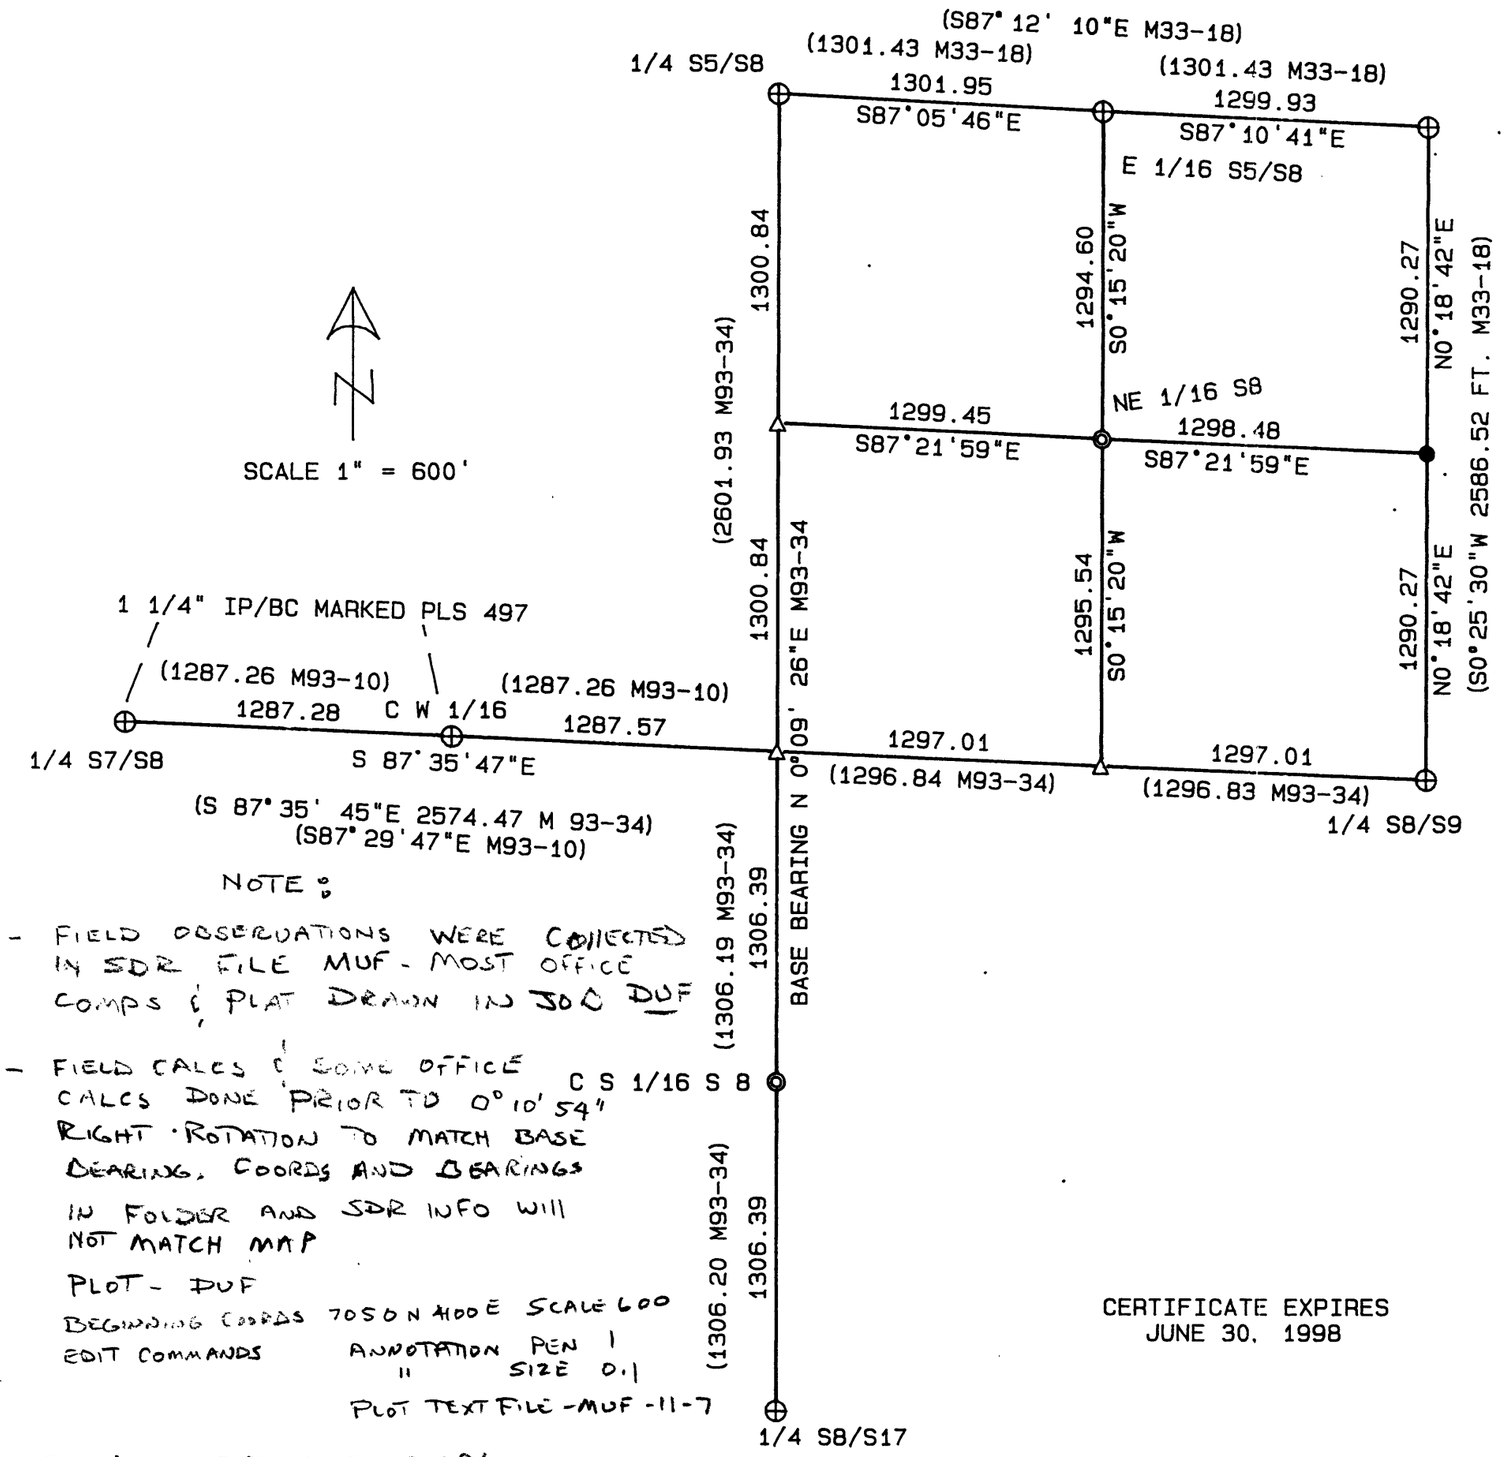

NOTE:

- FIELD OBSERVATIONS WERE COLLECTED IN SDR FILE MUF - MOST OFFICE COMPS & PLAT DRAWN IN JOB DUF
- FIELD CALCS & SOME OFFICE CALCS DONE PRIOR TO 0°10'54" RIGHT ROTATION TO MATCH BASE BEARING. COORDS AND BEARINGS IN FOLDER AND SDR INFO WILL NOT MATCH MAP

PLOT - DUF

BEGINNING COORDS 7050 N 4100 E SCALE 600

EDIT COMMANDS ANNOTATION PEN 1

" SIZE 0.1

PLOT TEXT FILE - MUF - 11-7

PEN 1 = 0.35, PEN2: FIBER 2P/+ FINE PEN3 = 0.5

CERTIFICATE EXPIRES
JUNE 30, 1998

SURVEY DATE: APRIL 1998

SURVEY BY DOUGLAS COUNTY SURVEYOR'S OFFICE
RM. 105-A COURTHOUSE ROSEBURG, OR. 97470

SECTION 8 WAS SUBDIVIDED ACCORDING TO THE MANUAL OF SURVEY INSTRUCTION. CONTROLLING CORNERS WERE FOUND AND USED AS SHOWN.

BEARINGS WERE BASED ON THE NORTH-SOUTH CENTER LINE AS SHOWN BY GEISLER M 93-34.

LEGEND:

⊕ FOUND DCSO BC UNLESS OTHERWISE NOTED

◎ SET 2 3/8" DIA. BRASS CAP ON 1 5/8" OD X 32" GALV. IP. CAPS MARKED DOUGLAS CO. SURVEYOR'S OFFICE. SEE DCSO CORNER RECORDS FOR BT AND ADDITIONAL INFORMATION.

● SET 5/8" X 30" IRON ROD WITH ALUM. CAP MARKED DOUGLAS CO. SURVEYOR'S OFFICE. SEE DCSO CORNER RECORDS FOR BT AND ADDITIONAL INFORMATION.

△ CALCULATED POINT - NOT FOUND - NOT SET.

C.S. File No. 66/3

CS FILE FOLDER

CONTAINS

MORE

INFORMATION