R

FILED

GOVERNMENT CORNER RESTORATION FORM

Date: 4-23-1999 By: JC

This survey consists of:
Map:
Narrative:
Corner Rpt: 66/8-14

Township 27S Range 7W Sec. 11 County DOUGLAS

State OR Date 2-9-1999 No. 600500.012

Corner Designation

S11	S12
S14	S13

DOUGLAS COUNTY
SURVEYOR
Condition Report Only
✓ Condition
Not Found
✓ Renewed
Unrecorded
Surveyed In
Referenced Out

Previous Renewals 1960 DCSO

MONUMENT DETAIL

Monument(s) Found: (Condition and Source)

2½" DIA BRASS CAP ON A 1½" DIA IRON PIPE PROTRUDES 12" ABOVE GROUND 1960

COUNTY SURVEYORS OFFICE

T27S R7W

S11	S12
S14	S13

1960

Accessories Found:

20" NOW 20" DIA W. OAK WITH A FULLY HEALED DOUBLE BLAZE WITH RAISED SCRIBING VISIBLE AND HEALED BLAZE "T27S R7W S" BEARS N 22°E 40.5 FT (AGREES WITH REC.) / 1960

7" NOW 10" DIA. W. OAK WITH A FULLY HEALED DOUBLE BLAZE BEARS N 49°W 32.0 FT / (AGREES WITH REC.) 1960 /

10" NOW 20" DIA W. OAK WITH A FULLY HEALED DOUBLE BLAZE BEARS S 33°W 96.9 FT (REC. S 33°W 97.6 FT DIST IS A SLOPE MEASUREMENT) / 1960

19" NOW 25" DIA 1½ FT HIGH D. FIR STUMP WITH A FULLY HEALED BLAZE BEARS S 23½°E 96.5 FT (AGREES WITH REC.) 1960 /

18" NOW 19" DIA W. OAK WITH A FULLY HEALED DOUBLE BLAZE BEARS S 2°E / 342 FT (AGREES WITH / 1960 REC.) SOURCE UNKNOWN.

C ✓

G.S. File No. 66/844

RENEWAL

Monument Set (Procedure and Description)

NONE

Monument Detail

N/A

New Accessories

NONE

Sketch of Monument, Acessories, and General Area

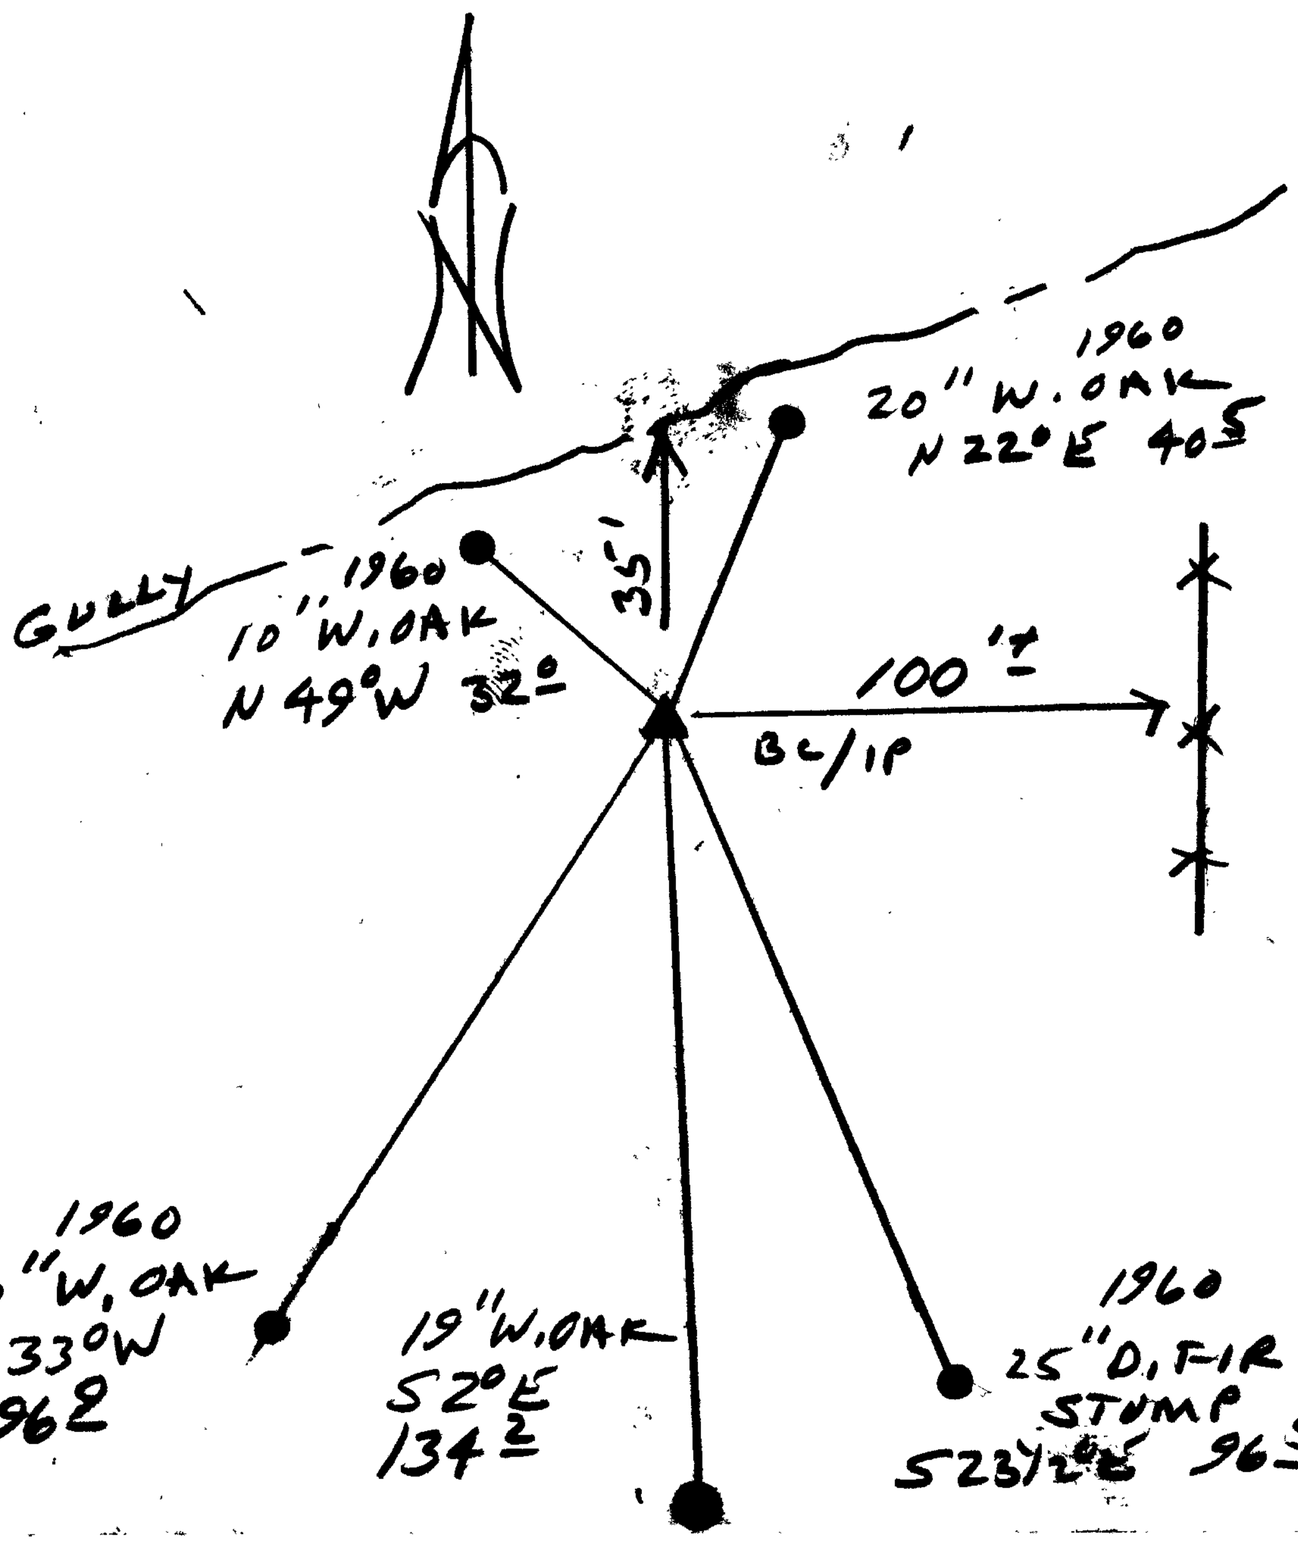

Location & Comments

CORNER LIES 35 FT SOUTH OF A SMALL GULLY THAT RUNS EASTERLY AND APPROX. 140 FT WESTERLY OF A MEANDERING N-S FENCE LINE

Comp. Declin. 17¾° E

Agency USFS

Party Chief RANDALL W. SMITH

Notekeeper [illegible]

Witnesses STEPHEN [illegible]

Address

Surveyor's Seal

REGISTERED
PROFESSIONAL
LAND SURVEYOR

[signature]
6-20-2001

OREGON
JULY 25, 1990
RANDALL W. SMITH
2469