FILED

GOVERNMENT CORNER RESTORATION FORM

Date: 10/18/1999 By: JC

This survey consists of:
Map: ____
Narrative: ____
Corner Rpt: 66/12-14

Township 29S Range 5W Sec. 19 County DOUGLAS

State OR Date 8-23-99 No. 200300019

DOUGLAS COUNTY SURVEYOR

Corner Designation

S19	S20
S30	S29

___ Condition Survey Only
___ Not Found
✓ Renewed
___ Unrecorded
___ Surveyed In
___ Referenced Out

Previous Renewals NONE

MONUMENT DETAIL

Monument(s) Found: (Condition and Source)

NONE

N/A

Accessories Found:

14" NOW 29" DIA W. OAK WITH A HOLE, SHOWING EVIDENCE OF BEING OPENED AT LEAST TWICE ONCE BY AXE AND ANOTHER TIME BY CHAIN SAW. I OPEN FURTHER AND FIND REVERSE SCRIBE MARK "S", BEARS N65°E, 181.5 FT.

WE RESCRIBE HIGH ABOVE OPENED BLAZE, APPROX. 3½ FT ABOVE GROUND ON A SINGLE BLAZE "S20 BT".

NO OTHER BT'S FOUND

C.S. File No. 66/12-14

RENEWAL

Monument Set (Procedure and Description)

2 3/8" DIA BRASS CAP ON A 1 3/8" O.D. BY 32" LONG BRASS CAP IS SET AT A POSITION DETERMINED BY ORIG. BT. PROTRUDES 8" ABOVE GROUND.

Monument Detail

DOUGLAS COUNTY SURVEYORS

T 29 S
R 5 W

S19	S20
S30	S29

1999
OFFICE

New Accessories

13" DIA. D.FIR DOUBLE BLAZED AND SCRIBED "T29SR5WS19CSBT"
BEARS N 78° W 42.1 FT
15" DIA. D.FIR DOUBLE BLAZED AND SCRIBED "T29SR5WS30CSBT"
BEARS S 76½° W 42.3 FT
12" DIA. CEDAR DOUBLE BLAZED AND SCRIBED "T29S R5W S20CSBT"
BEARS N26½°E, 123.0 FT

Sketch of Monument, Acessories, and General Area

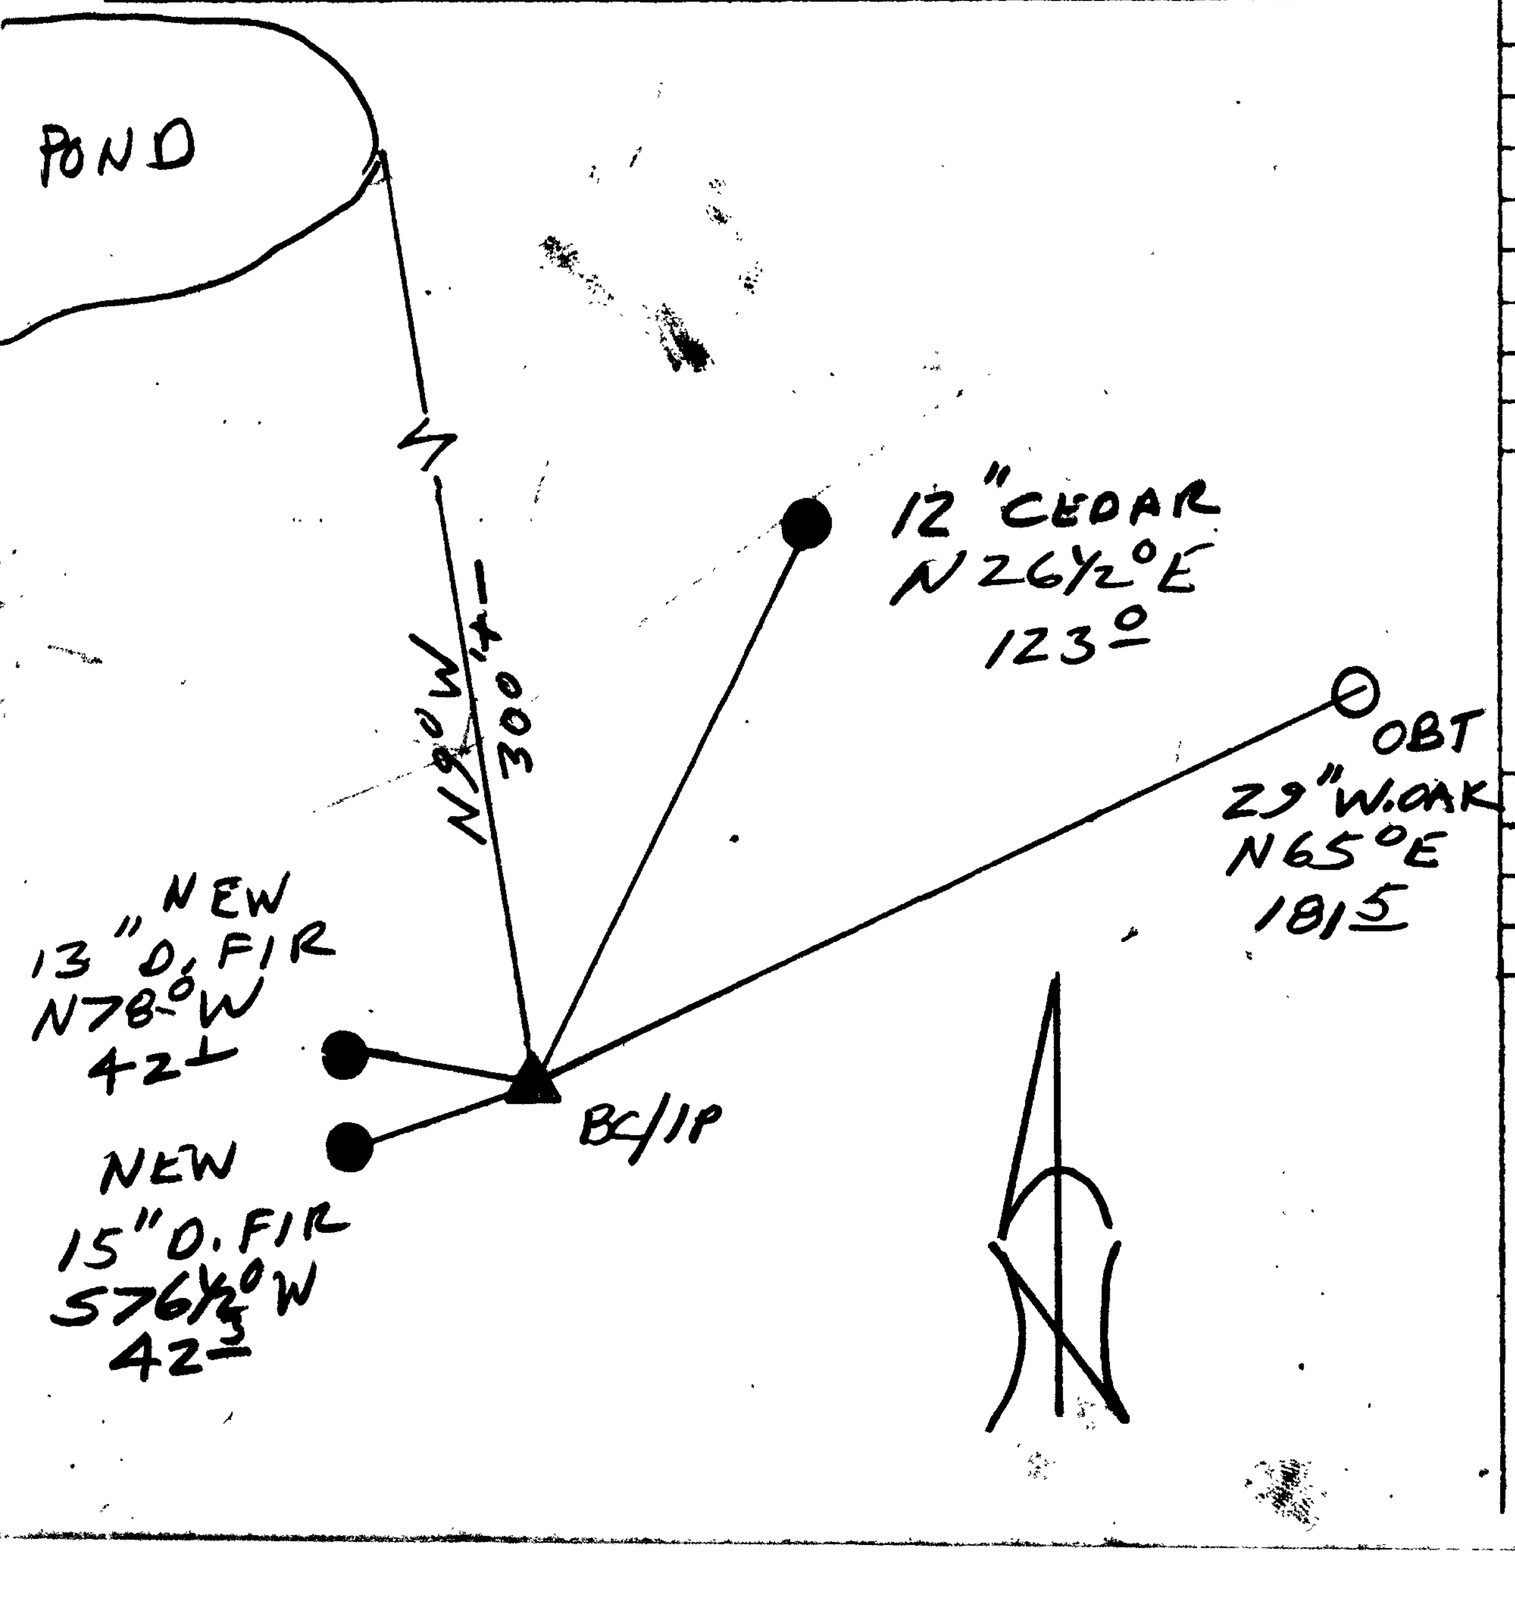

Location & Comments

EASTERLY EDGE OF POND BEARS N 9° W APPROX 300 FT.
METAL WITH POST & SIGN SET 2 FT NORTH OF CORNER

Comp. Declin. 17 3/4° E
Agency DCSO
Party Chief RANDALL W SMITH
Notekeeper [illegible]
Witnesses STEPHEN T FLUKE

Address

Surveyor's Seal

REGISTERED
PROFESSIONAL
LAND SURVEYOR

Randall W Smith
EXPIRES 6-30-2000

OREGON
JULY 25, 1980
RANDALL W. SMITH
2486