T28S R8W N1/16 S23 S24

1-25-00 RANDALL W SMITH
STEPHEN J FLAUSE

FD 5/8" IRON ROD 12" BELOW
GROUND
26" DIA CEDAR WITH A HEALED
SCAR 1972 BT TAG
" S33½°E $43^{\underline{0}}$ "
17" DIA CEAR STUMP WITH A
HEALED SCAR 1972 BT TAG
" S44°W $21^{\underline{0}}$ "

AREA AROUND CORNER BEING
LOGGED IN FUTURE ROCK
QUARRY.

THE ABOVE CORNER SET BY
BAUGHMAN SEE M49-10
NO MENTION OF BT'S

SET TWO 5/8" X 30"
LONG IRON ROD'S AWAY
FROM AREA SEE BACK
FOR SKETCH

FILED FEB 8 2000
600360

C.S. File No. 66/14-10

J L DARLING CORP
TACOMA WASH U.S.A.
"Rite in the Rain"® WEATHERPROOF
No. 302

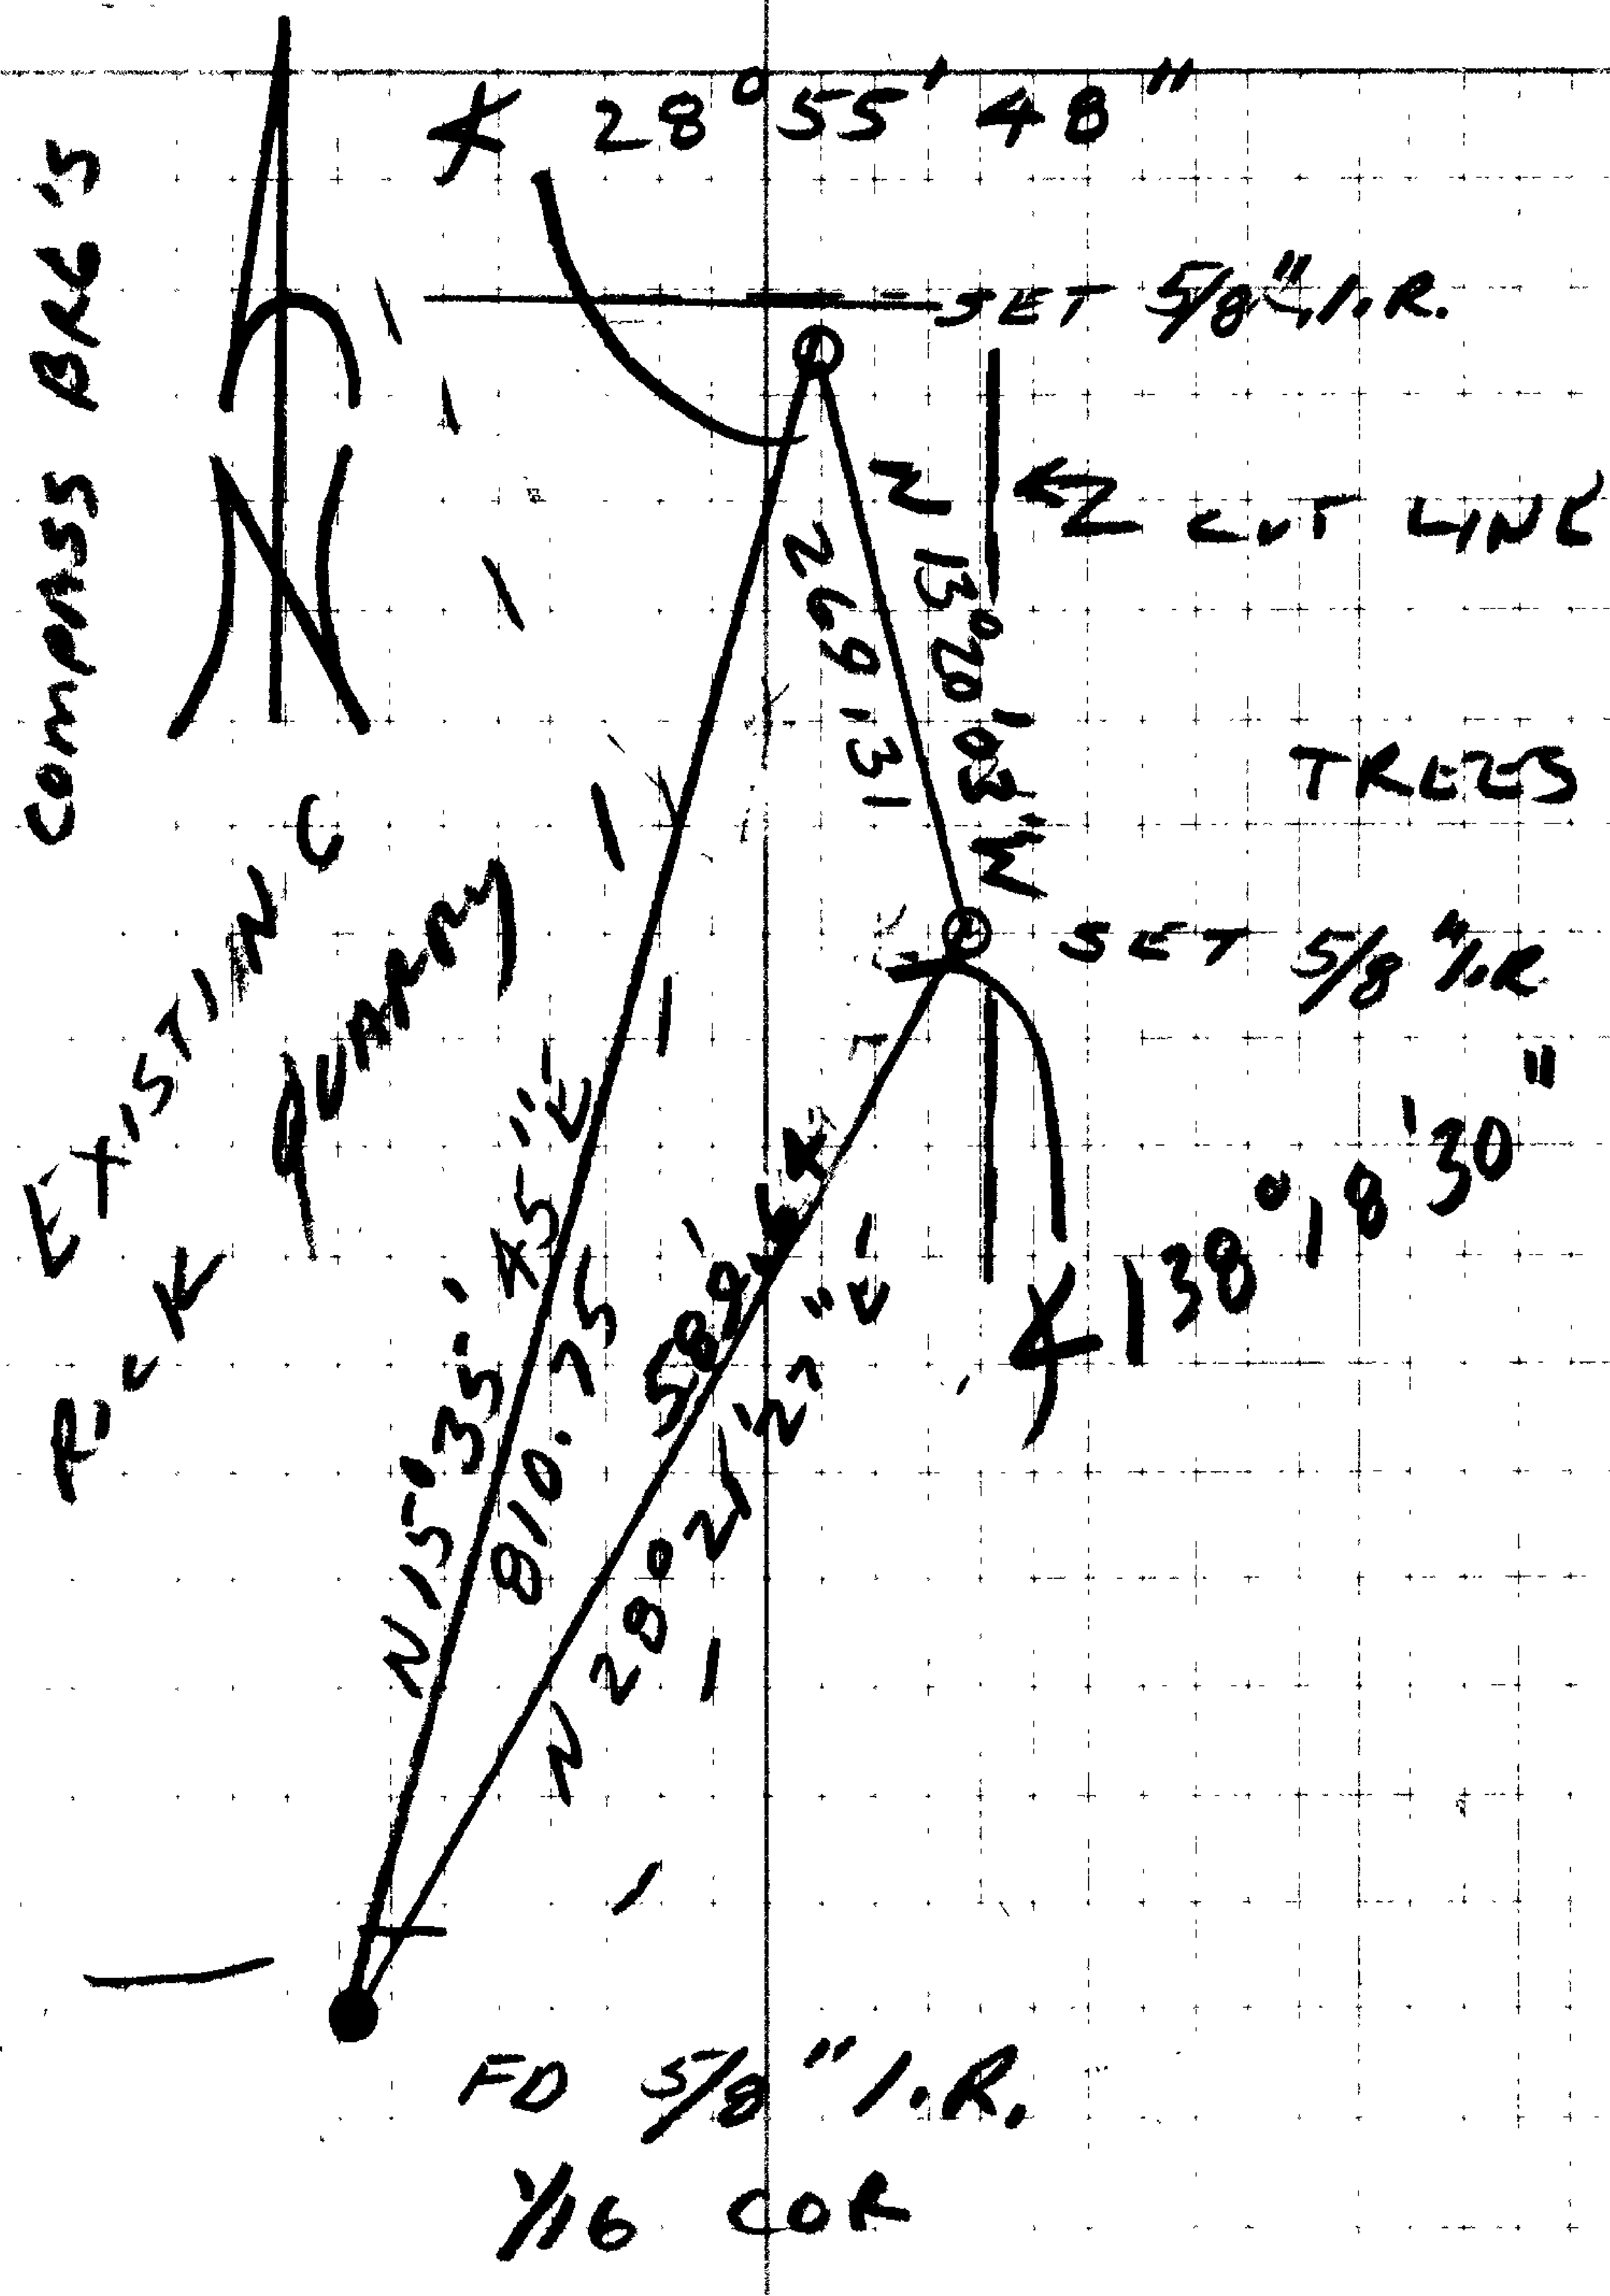
COMPASS BRG'S
∡ 28°55'48"
SET 5/8" I.R.
N 13°20'03" W
269.31
CUT LINE
TREES
SET 5/8" I.R.
∡ 138°18'30"
EXISTING
ROCK QUARRY
N 15°35'45" E
810.75
N 28°21'27" E
589.4
FD 5/8" I.R.
1/16 COR

CS 66/14-10