


# 1914 SURVEY

10-23-01

RANDALL W SMITH

(RECORD PER VOL 5 Pg 20A)

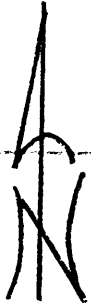

10,000  
10,000

① 10,000  
12,695

② 10,000  
14,692.9

1/4 COR

(EAST)

POINT ON  
DLC LINE

NE COR DCC 39

3/4" I.P. FD  
OUT OF  
GROUND

3/4" I.P.  
FD

FD 1/2"  
I.R.

③

N.F.

(N 89° 54 1/2' W)

NO (674.4)

(2007.9)

(2630.8)

(622.9)

1/4 S 10 1/2' E

POSITION

BOLT

N.F.

3/4" I.P.

1961 DCSO

BC/1P

N 79° W 4.8'

9991.5  
15315.8

OUR MEASUREMENTS OF FOUND MONUMENTS

BASES OF BRG EAST BETWEEN ① AND ②

① — ② EAST, 2008.1 (EAST, 2007.9 CALC.)

① — ③ N 89 3/4° W, 2629.6 (N 89 3/4° W, 2630.8 CALC.)

② — ③ N 89° W, 621.6 (N 89 1/4° W, 622.9 CALC.)

C.S. File No. 06/29-18 C<sub>4</sub>  
19B