GOVERNMENT CORNER RESTORATION FORM

FILED
Date: 2/1/2005 By: JC
This survey consists of:
Misc.
Notes
Corner Apt: 67/10-7

DOUGLAS COUNTY SURVEYOR

Township 30S Range 5W Sec. 4 County DOUGLAS

State OR Date 2/24/05 No. 037040

Corner Designation

SE Cor. DLC No. 37

Condition Only
___ Not Found
_✓_ Renewed
___ Unrecorded
___ Surveyed In
___ Referenced Out

Previous Renewals MAY 1917 GERMOND OLD CORNER BOOK PG. 145

MONUMENT DETAIL

Monument(s) Found: (Condition and Source)

3/4" I.D. IRON PIPE WITH MUSHROOMED TOP PROTRUDING 6" OUT OF GROUND.

Accessories Found:

- 16" B.OAK NOW 23" BEARS S 63½°E, 29.7 FT. 1969 BT TAG INTACT., AGREES W/1917 RECORD

- 14" B.OAK NOW 15" STANDING DEAD, BEARS S 44°W, 24.4 FT REC. S 43° 50'W, 24.4 FT. (MAY 1917)

C.S. File No 67/10-7

RENEWAL

Monument Set (Procedure and Description)

N/A

Monument Detail

New Accessories

- 15" MADRONE, DOUBLE BLAZED & SCRIBED "SE DLC 37 CS BT" BEARS S 2° W, 26.2 FT.
- 14" D. FIR, DOUBLE BLAZED & SCRIBED "SE DLC 37 CS BT" BEARS N 86° W, 19.9 FT.
- 14" D. FIR, DOUBLE BLAZED & SCRIBED "SE DLC 37 CS BT" BEARS N 48° E, 8.6 FT.

Sketch of Monument, Acessories, and General Area

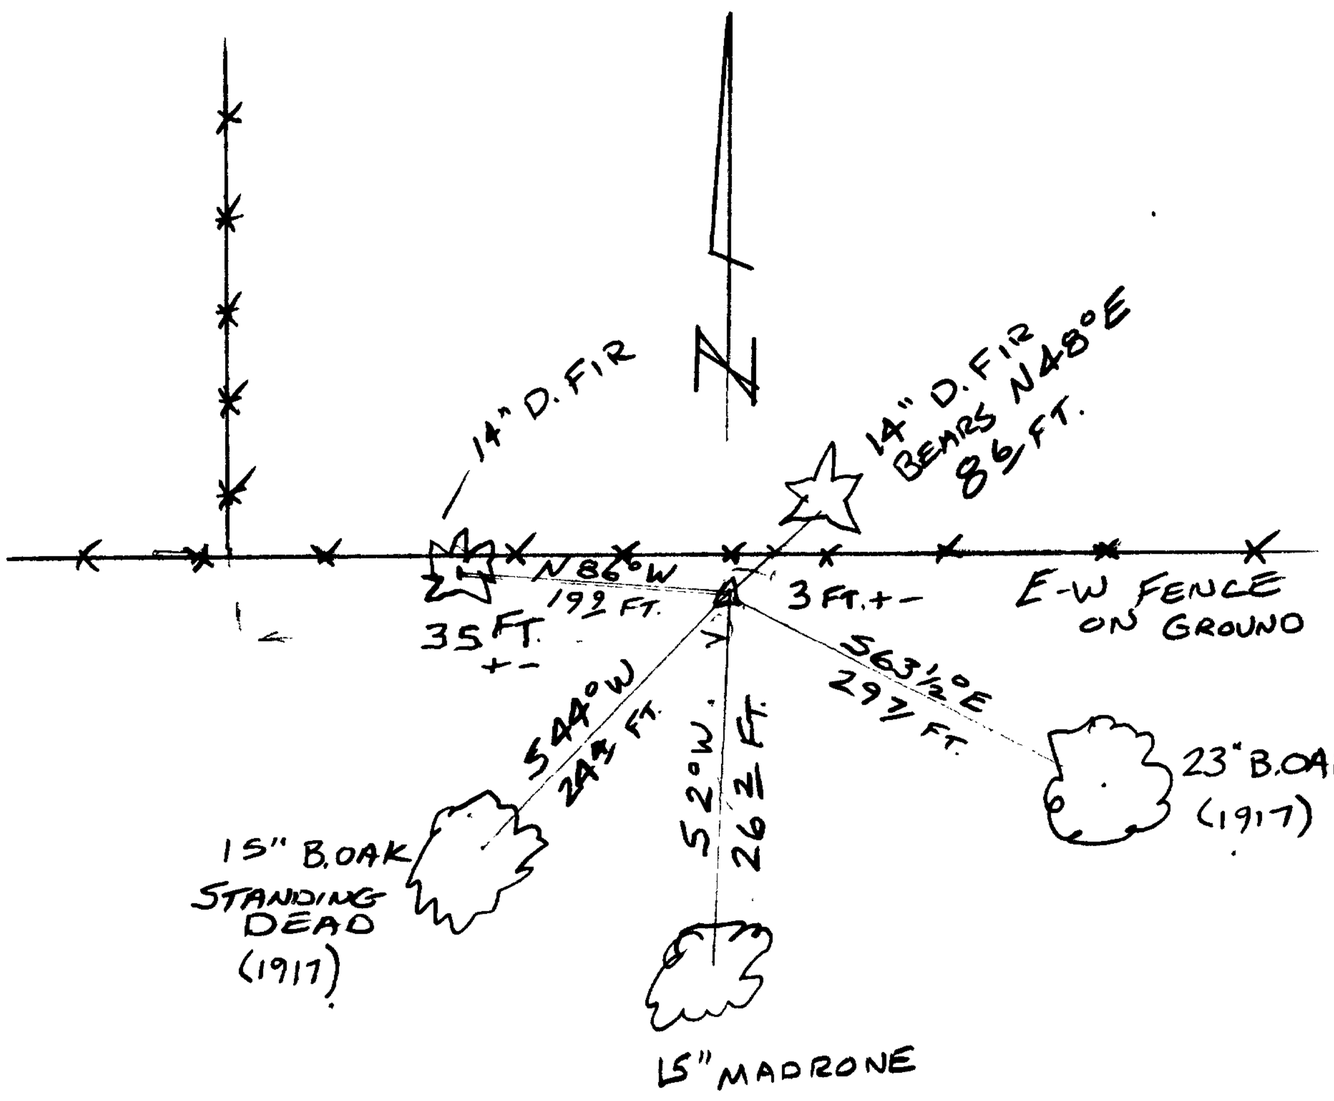

Location & Comments

CORNER LIES 3 FT SOUTH OF FALLEN E-W FENCE ON NORTH FACING SLOPE

GIS DATA C022410 A

Comp. Declin. 17° E
Agency D.C.S.I.
Party Chief S. FLAUSE
Notekeeper J. PIKE
Witnesses

Address

Surveyor's Seal

REGISTERED PROFESSIONAL LAND SURVEYOR
EXPIRES 6-30-2006
OREGON JULY 25, 1990 RANDALL W. SMITH 2469

67/10-7