GOVERNMENT CORNER RESTORATION FORM

FILED
Date: 6/28/2005 By: x
This Survey consists of:
Map:
Notes:
Corner Rpt: 67/10-34

DOUGLAS COUNTY SURVEYOR

Township 30S Range 5W Sec. 23 County DOUGLAS

State OR Date 6-21-2005 No. 052050

Corner Designation

E N E COR. FULLERTON
DLC Nº 52

___ Condition Report Only
___ Not Found
✓ Renewed
___ Unrecorded
___ Surveyed In
___ Referenced Out

Previous Renewals B. IRVING 1923

MONUMENT DETAIL

Monument(s) Found: (Condition and Source)

1" INSIDE DIA. IRON PIPE PROJECTS 1" ABOVE GROUND 0.8' WEST OF NORTH-SOUTH FENCE LINE.

Accessories Found:

42" DIA. PINE NOW ROTTED & BROKEN REMNANTS OF A 48" DIA BY 36" TALL STUMP. NO SCRIBING FOUND BEARS S 87¼°W, 130± FT. (REC. 1855 = S 89°W, 130± FT) (REC. 1923 = S 87°03' W, 129± FT.) ORIG. B.T.

28" B. OAK NOW ROOT HOLE WITH REMANATS OF WOOD & ROOTS IN DEPRESSION, BEARS S. 61½°W, 99± FT. (AGREES WITH REC.) 1923 BT

C.S. File No 67/10-34

RENEWAL

Monument Set (Procedure and Description)

Monument Detail

New Accessories

17" DIA MADRONE, DOUBLE BLAZED & SCRIBED "ENE DLC 52 CS BT"
BEARS S 28½° W, 15 5/ FT.
24" DIA PINE, DOUBLE BLAZED & SCRIBED "ENE DLC 52 CS BT"
BEARS S 84¼° W, 113 2 FT
AUTO TRUCK SPRING 3/8" THICK X 2½" WIDE, SPRING ARCHES AS IT ENTERS GROUND.
DIST. MEASURED TO NOTCH IN TOP, BEARS N 3/4° E, 65.73 FT.
(NW COR. DLC 53)

Sketch of Monument, Acessories, and General Area

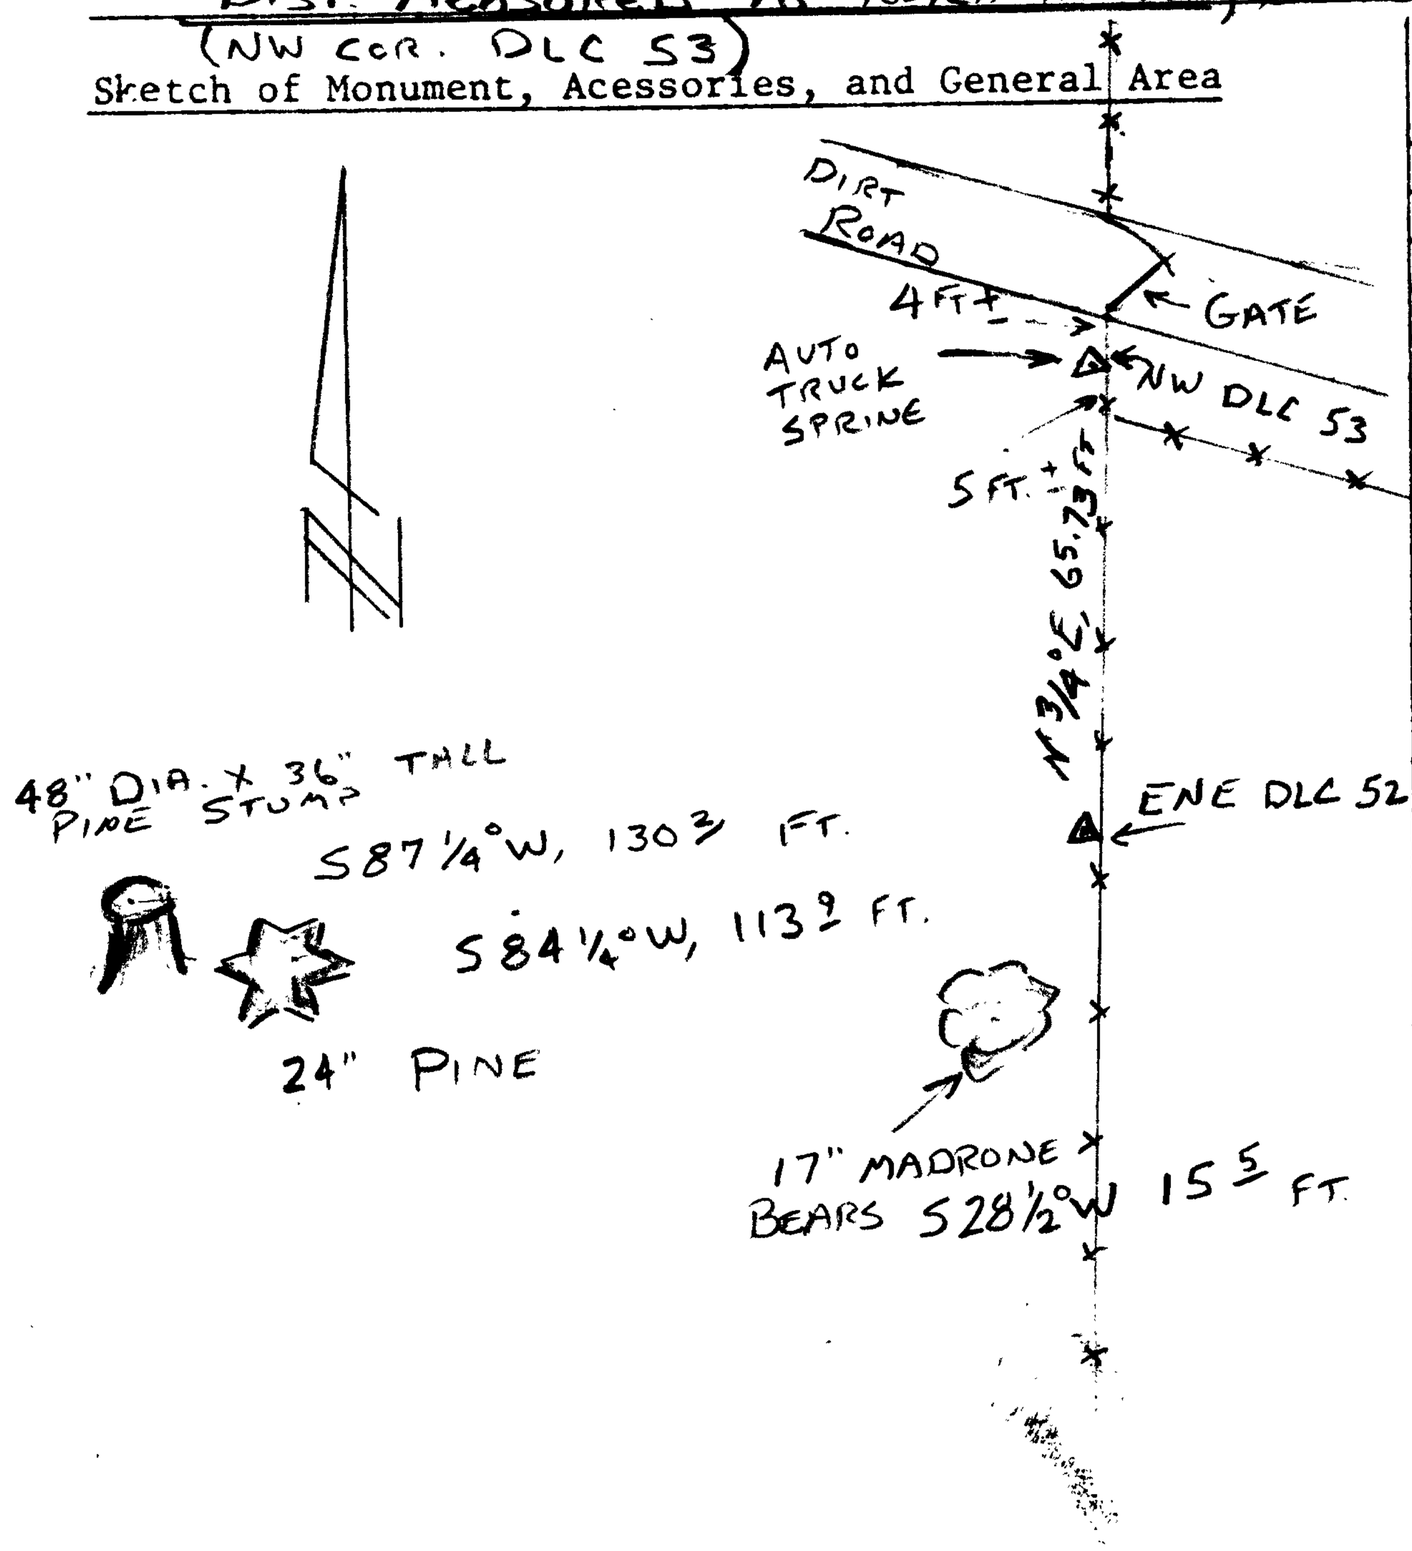

Location & Comments

LIES JUST WEST OF N-S FENCELINE IN ROLLING PASTURE LAND WITH SPARSLY SCATTERED TREES.

Comp. Declin. 16 3/4° E
Agency DCSO
Party Chief S. CLAUSE
Notekeeper J. PIKE
Witnesses

Address

Surveyor's Seal

REGISTERED PROFESSIONAL LAND SURVEYOR

Randall W. Smith
EXPIRES 6-30-06

OREGON
JULY 25, 1990
RANDALL W. SMITH
2469

67/10-34