FILED

Date: 8-16-2005 By: JC

This survey consists of:

Map: _____

Narrative: _____

Corner Rpt: 67/10-39

DOUGLAS COUNTY SURVEYOR

GOVERNMENT CORNER RESTORATION FORM

Township 22 S Range 8 W Sec. 10 County DOUGLAS

State OR Date 7-21-05 No. 440500

Corner Designation

1/4 S 10 / S 15

____ Condition Report Only
____ Not Found
✓ Renewed
____ Unrecorded
____ Surveyed In
____ Referenced Out

MONUMENT DETAIL

Previous Renewals

Monument(s) Found: (Condition and Source)

5/8" IRON ROD - NO CAP - APPROX. 6" BELOW GROUND. HAINES, 1974

Accessories Found:

24" NOW 34" DIA D. FIR - HEALED BLAZE VISIBLE BEARS S43°E, 19½ FT. 1974 BT (AGREES W/REC.)

NO TRACE OF 1974 NE B.T. FALLS IN LOGGING RD. (REC. 10" FIR N 52°E, 27½)

C.S. File No 67/10-39

RENEWAL

Monument Set (Procedure and Description)

N/A

Monument Detail

New Accessories

15" DIA. D. FIR DOWELL BLAZED & SCRIBED "1/4 S15 CS BT"
BEARS S 89 1/4° E, 73 6 FT.
27" DIA. D. FIR, DOUBLE BLAZED & SCRIBED "1/4 S15 CS BT"
BEARS S 22 1/2° W. 24 8/ FT.
23" DIA. W. OAK, DOUBLE BLAZED & SCRIBED "1/4 S10 CS BT"
BEARS N 60 3/4° W, 115 7/ FT.

Sketch of Monument, Acessories, and General Area

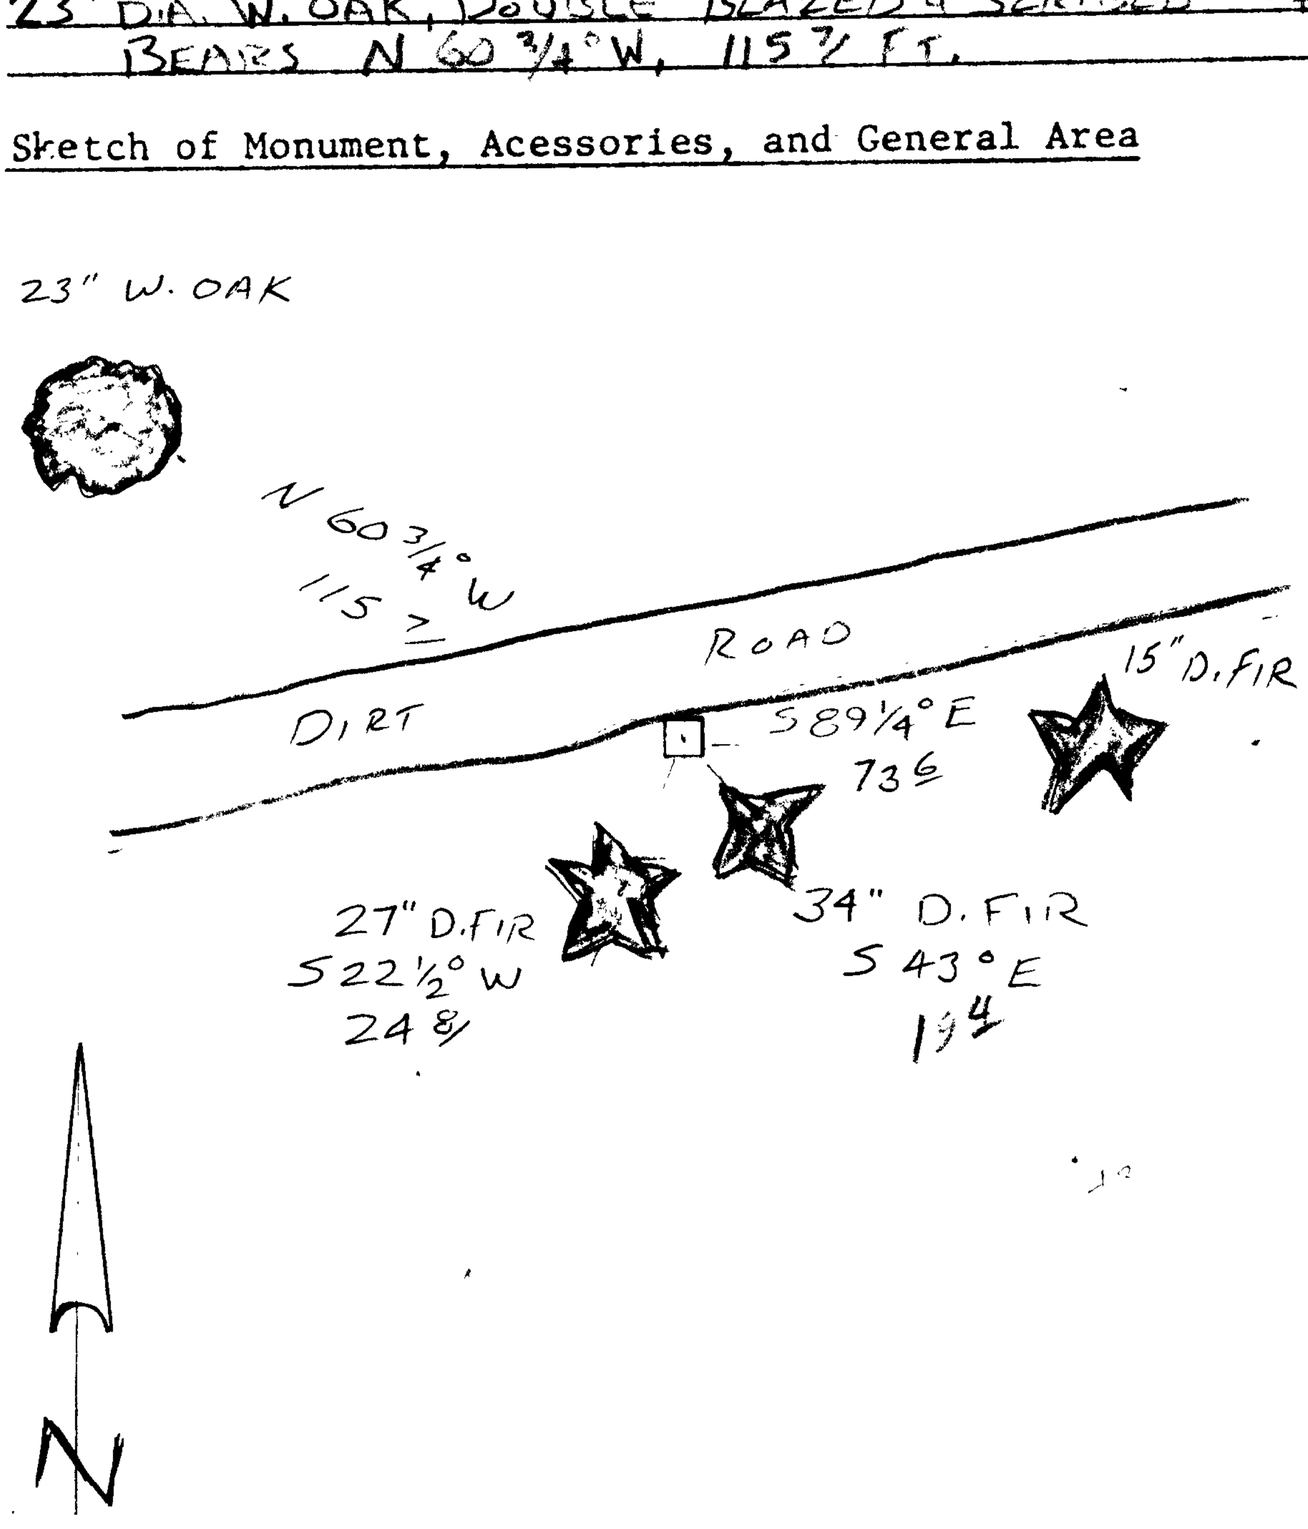

Location & Comments

CORNER LIES ON NEARLY FLAT LAND ON SOUTH EDGE OF LOGGING RD. ROAD
BEARS N 90° E - S 90° W

GPS SESSION 041910A

Comp. Declin. 16 3/4° E
Agency D.C.S.O.
Party Chief S. FLAUSE
Notekeeper J. PIKE
Witnesses

Address

Surveyor's Seal

REGISTERED
PROFESSIONAL
LAND SURVEYOR

EXPIRES 6-30-06

OREGON
JULY 25, 1990
RANDALL W. SMITH
2469

67/10-39