GOVERNMENT CORNER RESTORATION FORM

FILED
Date: 12/14/2005 By: JC
This survey consists of:
Map:
Narrative:
Corner Rpt: 67/13-14

DOUGLAS COUNTY SURVEYOR

Township 23S Range 6W Sec. 9 County DOUGLAS

State OR Date 6-13-05 No. 40050

Corner Designation

S9	S10
S16	S15

___ Condition Report Only
___ Not Found
✓ Renewed
___ Unrecorded
___ Surveyed In
___ Referenced Out

Previous Renewals G.L.O. ORIG. 1883; BLM 1955

MONUMENT DETAIL

Monument(s) Found: (Condition and Source)

2½" B.C. ON 2" IRON PIPE
PROJECTS 5" ABOVE GROUND

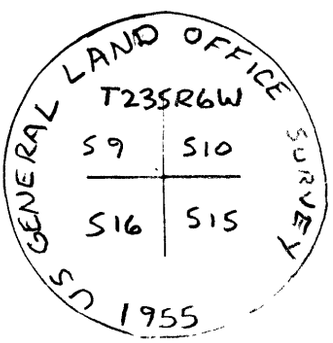

Accessories Found:

30" NOW 42" DIA MAPLE, HEALED BLAZE VISIBLE
BEARS S 42½° W, 56 6/ FT.

- ROTTED REMAINS OF FIR STUMP BEARS N 22° W 33 0 FT
10" TO 24" DIA. FIR BARK FOUND ON STUMP

10" NOW 24" x 5' TALL D. FIR STUMP HEALED A LOW BLAZE VISIBLE
BEARS S 59½° E, 38 3/ FT. 1955 BT (REC. S70°E, 38 3/ FT.)

53" NOW 56" DIA. x 5' TALL PREVIOUSLY OPENED D. FIR STUMP
GROWTH RINGS WERE COUNTED & TREE WAS THE CORRECT AGE
FRAGMENTARY SCRIBING WAS FOUND EXPOSED AND FACING
APPROX. S 22°E (REC. N 22° W), WE CUT INTO TREE
LOWER THAN WAS PREVIOUSLY OPENED AND FOUND
SCRIBE "BT" ON APPROX. 9½" DIA. THIS SCRIBE
FACES APPROX S 67°E. FD. "BT" SCRIBE IS
ABOUT 1½ FT LOWER THAN PREV. EXPOSED FACE.
THIS TREE IS POSSIBLY THE ORIG. N W BT PER FD. SCRIBE
(ORIG. REC. N 22° W, 33 0 FT.) THIS TREE BEARS N 36° E, 29 0 FT.
FROM FD. BC/IP

C.S. File No 67/13-14

RENEWAL

Monument Detail

Monument Set (Procedure and Description)

New Accessories

5" DIA. D. FIR, DOUBLE BLAZED & SCRIBED "X CSBT" BEARS S 55°E, 9½ FT.
11" DIA. D. FIR, DOUBLE BLAZED & SCRIBED "T23S R6W S9 CS BT"
BEARS N 46 3/4° W, 27½ FT.
7" DIA. D. FIR, DOUBLE BLAZED & SCRIBED "T23S R6W S10 CS BT"
BEARS N 54° E, 6½ FT.

Sketch of Monument, Acessories, and General Area

6'

T23S R6W S21

Location & Comments

GPS SESSION = C071312A

Comp. Declin. 16 3/4° E
Agency DCSO
Party Chief SJF
Notekeeper JP
Witnesses

Address

Surveyor's Seal

REGISTERED
PROFESSIONAL
LAND SURVEYOR

EXPIRES 6-30-06

OREGON
JULY 25, 1990
RANDALL W. SMITH
2469

67/13-14