FILED

Date: 2-21-2006 By: X

GOVERNMENT CORNER RESTORATION FORM

Township 23 S Range 5 W Sec. 19 County DOUGLAS

State OREGON Date FEB. 6, 2005 No. 140300

The survey consists of:
Map:
Narrative:
Corner Rpt: 67/14-6

DOUGLAS COUNTY SURVEYOR

Corner Designation

1/4 COR 5 19 / 5 30

____ Condition Report Only
____ Not Found
✓ Renewed
____ Unrecorded
____ Surveyed In
____ Referenced Out

Previous Renewals THEIL, 1908; DCSO, 1959

Monument(s) Found: (Condition and Source)

1 1/4" U-BAR, PROJECTS 5" ABOVE GROUND, FIRM.

MONUMENT DETAIL

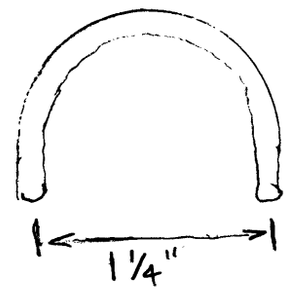

Accessories Found:

15" NOW 34" DIA. D. FIR, HEALED BLAZE VISIBLE BEARS S 9° E 17.2 FT. (REC. S9°E, 17.2 FT.) 1908 BT

20" NOW 29" DIA. X 1 1/2 FT. TALL ROTTING D. FIR STUMP, HEALED OVER AXE MARK FOUND BEARS N 38°W, 47 1/2 FT. (AGREES W/REC) 1959 BT

NO TRACE OF ORIGINAL BT'S FOUND

C.S. File No 67/14-6

RENEWAL

Monument Set (Procedure and Description)

Monument Detail

New Accessories

7" DIA. D. FIR, DOUBLE BLAZED & SCRIBED "1/4 S19 CSBT" BEARS N84°W, 5.6 FT.

11" DIA. D. FIR, DOUBLE BLAZED & SCRIBED "1/4 S19 CSBT" BEARS N 26°E, 18 3/4 FT.

Sketch of Monument, Acessories, and General Area

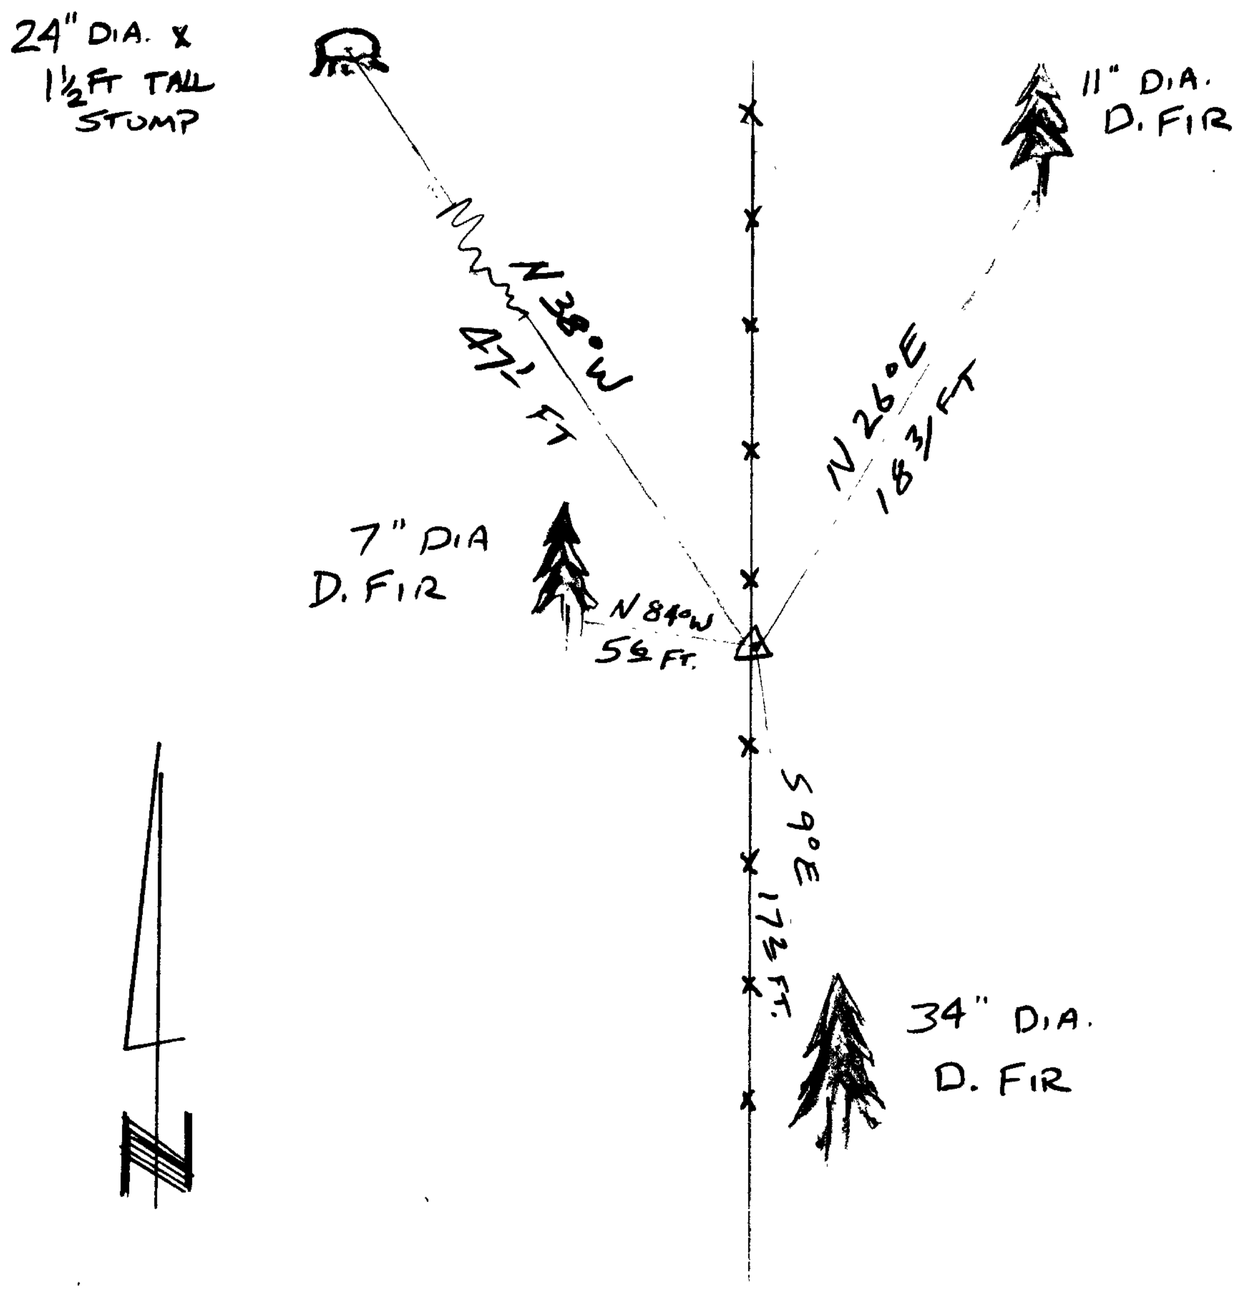

Location & Comments

CORNER LIES NEAR TOP OF RIDGE IN N-S FENCE LINE. FENCE TO WEST NOW REMOVED. (NO FENCE CORNER)

Comp. Declin. 16½° E
Agency D.C.S.O.
Party Chief S. FLAUSE
Notekeeper J. PIKE
Witnesses

Address

Surveyor's Seal

REGISTERED PROFESSIONAL LAND SURVEYOR

RENEWAL 6-30-2007

OREGON
JULY 25, 1990
RANDALL W. SMITH
2469