FILED
Date: 3/21/06 By: JC
This survey consists of:
Map:
Narrative:
Corner Rpt: 67/14-7

DOUGLAS COUNTY SURVEYOR

GOVERNMENT CORNER RESTORATION FORM

Township 30 S Range 5 W Sec. 1 County DOUGLAS

State OR Date 2-23-06 No. 640 700

Corner Designation

NORTH 1/4 COR FOR SEC. 1 ONLY

SEC 1

___ Condition Report Only
___ Not Found
✓ Renewed
___ Unrecorded
___ Surveyed In
___ Referenced Out

Previous Renewals BLM 1969

MONUMENT DETAIL

Monument(s) Found: (Condition and Source)

3 1/4" DIA. BRASS CAP ON 2 1/2" DIA. I.P. PROJECTS 5" ABOVE GROUND. FIRM.

DEPT. OF THE INTERIOR
1/4 S 1
T. 30S R 5W
1969
BUR. OF LAND MANAGEMENT

Accessories Found:

13" FIR, NOW 15" DIA. X 5 FT. TALL TIN COVERED ROTTING STUMP, HEALED SINGLE BLAZE VISIBLE BEARS S 81 1/4° E, 34 3/ FT. (REC. S 81 1/4° E, 34 3/ FT.) 1969 BT

25" FIR, NOW 23" DIA. X 1 1/2 FT. TALL TIN COVERED SOLID STUMP LOW HEALED BLAZE VISIBLE, BEARS S 16 1/2° W, 45 8/ FT. REC. DIST. MEASURES WELL ON SLOPE. (REC S 16 1/2° W, 47 2/ FT.) 1969 BT

45 3/

C.S. File No 67/14-7

RENEWAL

Monument Detail

Monument Set (Procedure and Description)

New Accessories

8" DIA. D. FIR, DOUBLE BLAZED & SCRIBED "T30S R5W ¼ S01 CS BT"
BEARS S 71½° E, 11.7 FT.
8" DIA. PINE, DOUBLE BLAZED & SCRIBED "T30S R5W ¼ S01 CS BT"
BEARS S 47½° W, 22 ½ FT.
6" DIA. PISTOL BUTT MAPLE, DOUBLE BLAZED & SCRIBED "T30S R5W ¼ S01 CS BT"
BEARS S 61¼° W, 47.6 FT.

Sketch of Monument, Acessories, and General Area

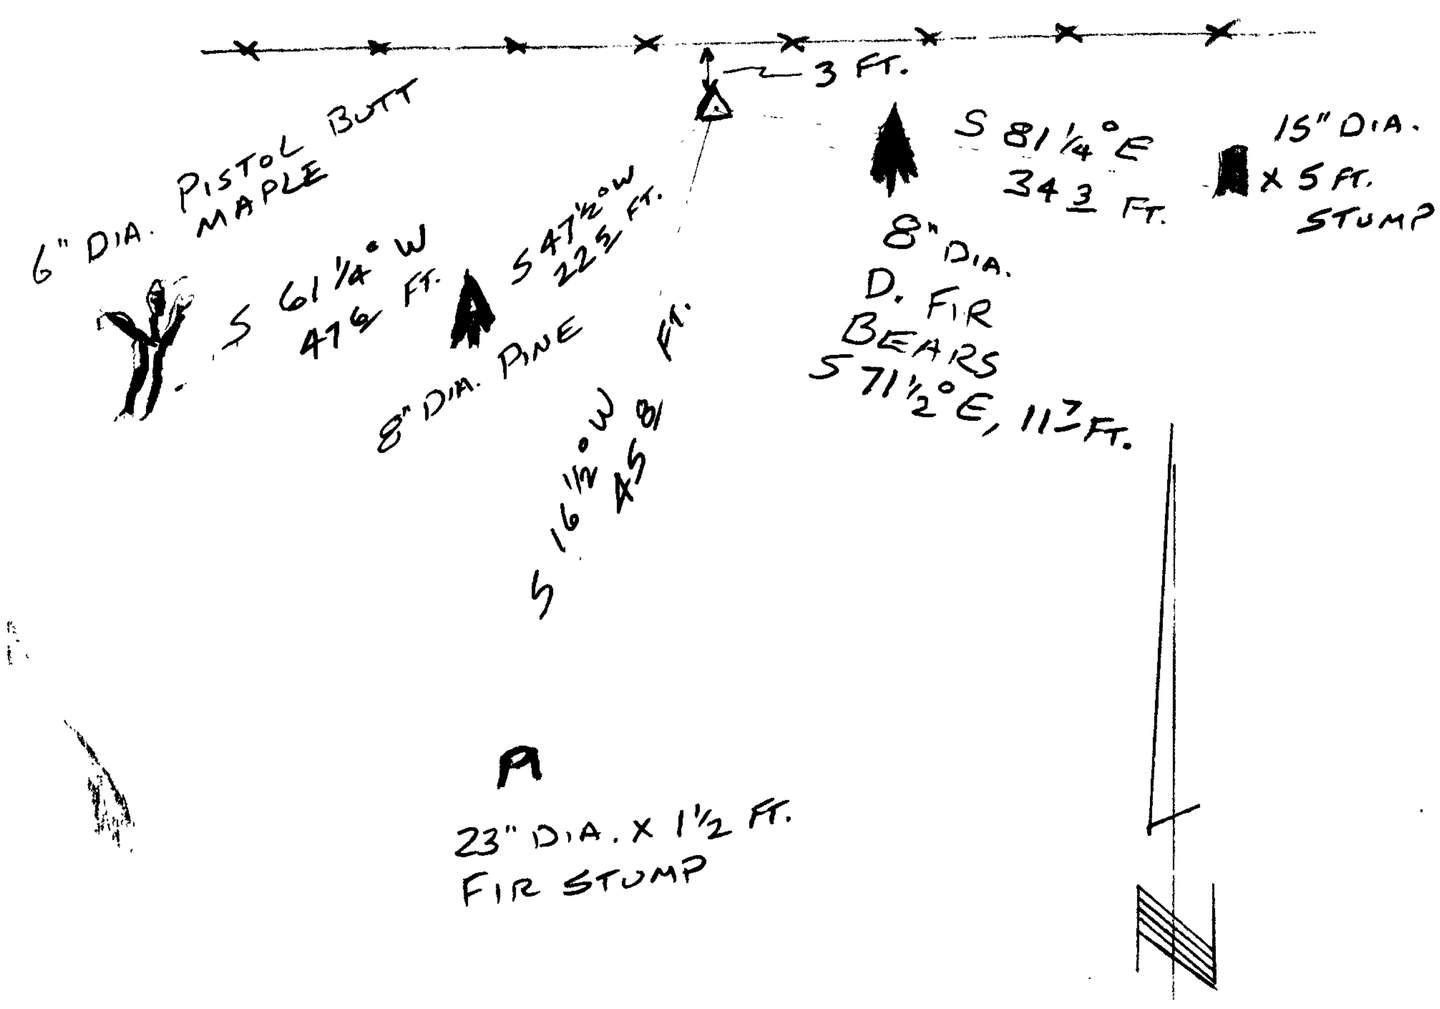

Location & Comments

CORNER LIES 3 FT SOUTH OF E-W RUNNING FENCE LINE ON GENTLE SOUTH FACING SLOPE

Comp. Declin. 16½° E
Agency D.C.S.O.
Party Chief S. FLAUSE
Notekeeper J. PIKE
Witnesses

Address

Surveyor's Seal

REGISTERED
PROFESSIONAL
LAND SURVEYOR
RENEWS 6-30-07
OREGON
JULY 25, 1980
RANDALL W. SMITH
2469

67/14-7