GOVERNMENT CORNER RESTORATION FORM

FILED
Date: 4-18-2006 By: JC
This survey consists of:
Map:
Narrative:
Corner Rpt: 67/14-12

Township 22S Range 8W Sec. 28 County DOUGLAS

State OR Date APRIL 13, 2006 No. 044110

Corner Designation

S SE CORNER DLC 44

DOUGLAS COUNTY SURVEYOR

Condition Reports Only
Not Found
✓ Renewed
Unrecorded
Surveyed In
Referenced Out

Previous Renewals D.C.S.O. FEB. 1955

MONUMENT DETAIL

Monument(s) Found: (Condition and Source)

2½" B.C. ON 1¼" O.D. IRON PIPE, MARKED AS SHOWN, FIRMLY SET PROJECTS 8" ABOVE GROUND.

SURVEYORS DLC 44 T22S R8W EXT L 1955 COUNTY OFFICE

Accessories Found:

ORIG. 10" R. FIR NOW 26" X 12" HIGH ROTTING STUMP BEARS S 9°E, 4.6 FT. (AGREES W/REC.) 1955 BT

NO TRACE OF 1955 SE BEARING TREE FOUND.

C.S. File No 67/14-12

RENEWAL

Monument Set (Procedure and Description)

N/A

Monument Detail

New Accessories

23" DIA. MAPLE DOUBLE BLAZED & SCRIBED "S SE DLC 44 CS BT" BEARS S 34¼° E, 78.0 FT.
7" DIA. W. FIR, DOUBLE BLAZED & SCRIBED "S SE DLC 44 CS BT" BEARS N 56½° E, 11.0 FT.
5" DIA. D. FIR, DOUBLE BLAZED & SCRIBED "X BT" BEARS S 70° W, 21.4 FT.
11" DIA. PISTOL BUTT MAPLE, DOUBLE BLAZED & SCRIBED "S SE DLC 44 CS BT" BEARS NORTH 61.3 FT.

Sketch of Monument, Acessories, and General Area

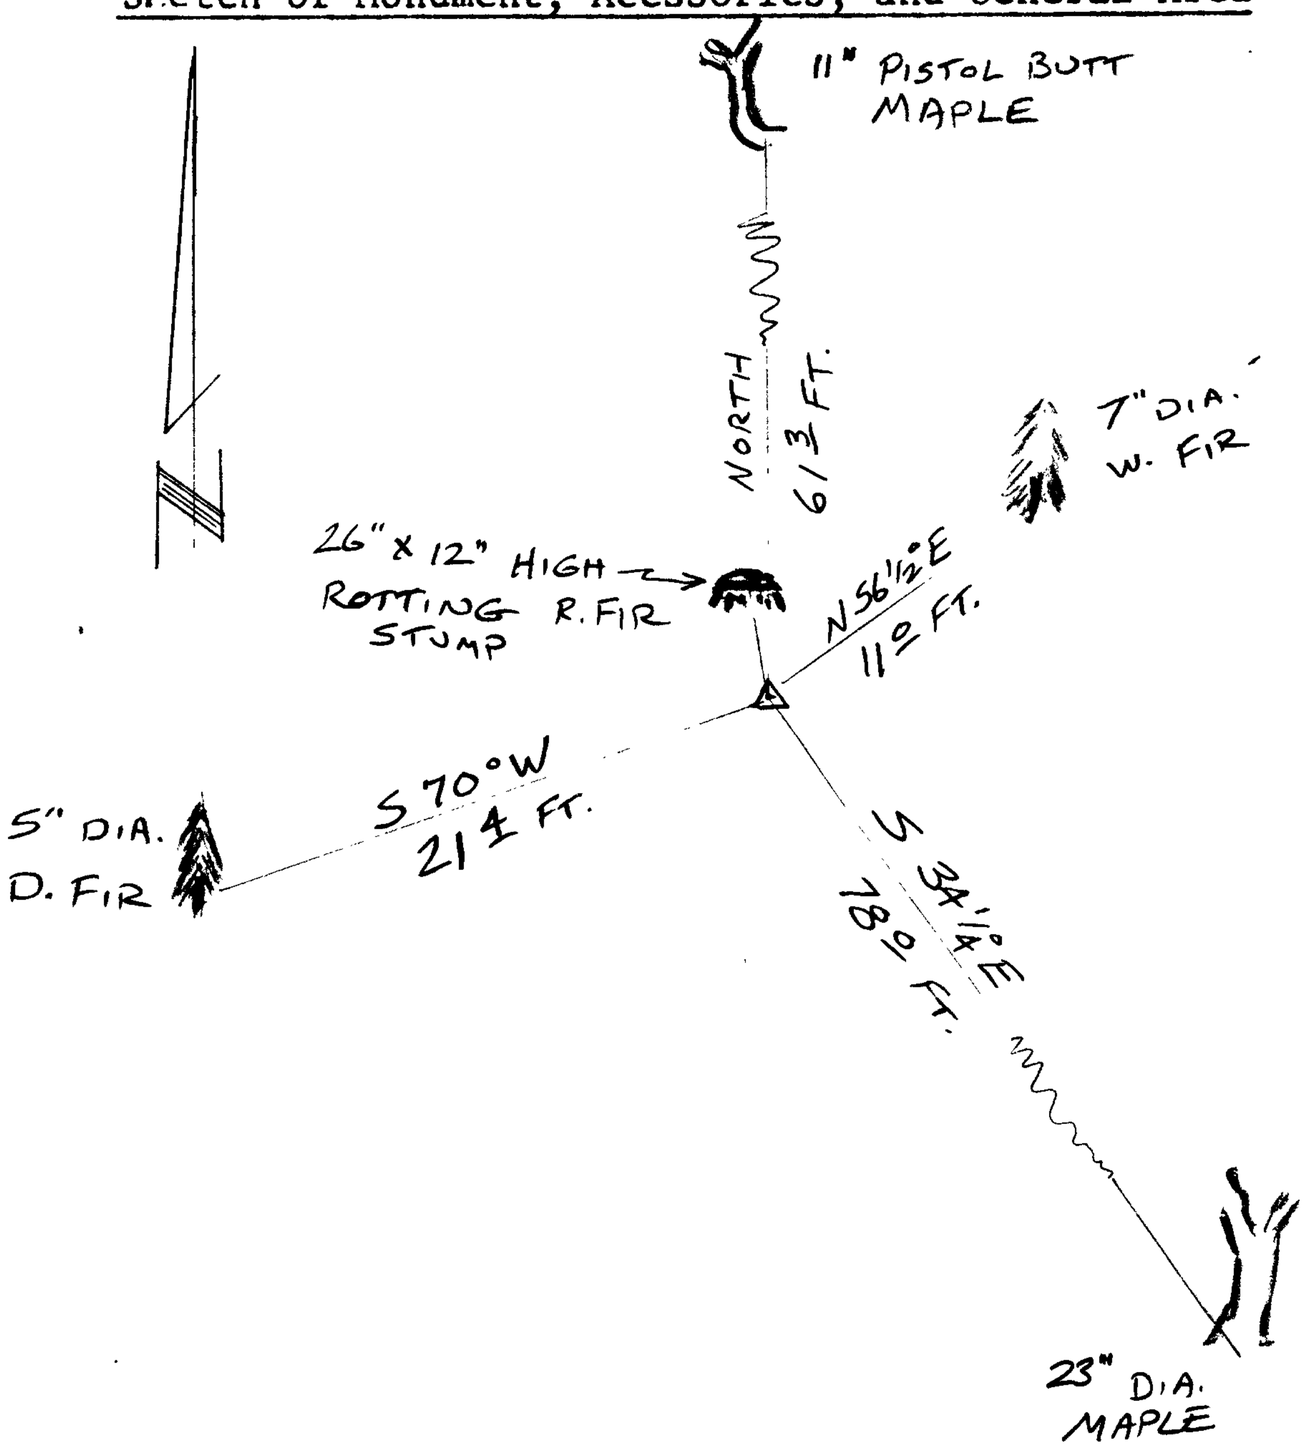

Location & Comments

CORNER LIES ON NEARLY LEVEL BENCH ABOVE CREEK. CENTER OF CREEK BEARS SOUTH APROX. 55 FT. FLOWS N 20° W

Comp. Declin. 16¼° E
Agency DLSO
Party Chief S. FLAUSE
Notekeeper J. PIKE
Witnesses

Address

Surveyor's Seal

REGISTERED PROFESSIONAL LAND SURVEYOR
Randall W. Smith
Expires 6-30-07
OREGON
JULY 26, 1990
RANDALL W. SMITH
2489

67/14-12