FILED

Date: 6-5-2006 By: JC

This survey consists of:

Map: _____

Narrative: _____

Corner Rpt: 67/14-15

**DOUGLAS COUNTY SURVEYOR**

GOVERNMENT CORNER RESTORATION FORM

Township 23 S Range 5 W Sec. 34 County DOUGLAS

State OR Date MAY 31, 2006 No. 500140

Corner Designation

1/4

SEC. 34 × SEC. 35

___ Condition Report Only
___ Not Found
✓ Renewed
___ Unrecorded
___ Surveyed In
___ Referenced Out

Previous Renewals D.C.S.O. AUG. 1940; D.C.S.O. NOV. 1957

MONUMENT DETAIL

Monument(s) Found: (Condition and Source)

3/4" INSIDE DIA. IRON PIPE, PROJECTS FROM GROUND 7". FIRMLY SET. IN E-W FENCELINE. (B.B.I. 1940)

Accessories Found:

16" NOW 29" W. FIR, HEALED DOUBLE BLAZE VISIBLE BEARS S 74° W, 29.4 FT. (REC. S 76° W, 29.4 FT.) 1959 BT

22" NOW 37" D. FIR, HEALED DOUBLE BLAZE VISIBLE BEARS S 81° E, 86.5 FT. (REC. S 81° E, 87.0 FT.) 1959 BT

17" DIA. D. FIR, HEALED SINGLE BLAZE VISIBLE. B.T. TAG IN PLACE, POSTED 9/96 BY "RFP" BEARS N 30° E, 10.9 FT. NO PREVIOUS RECORD OF THIS TREE.

10" DIA. D. FIR SNAG, HEALED SINGLE BLAZE VISIBLE. B.T. TAG IN PLACE, POSTED 9/96 BY "RFP" BEARS N 65½° W, 19½ FT. NO PREVIOUS RECORD OF THIS TREE. SNAG TO BE REMOVED SOON.

NO TRACE OF ANY OTHER B.T.'S OF RECORD

C.S. File No 67/14-15

RENEWAL

Monument Set (Procedure and Description)

Monument Detail

New Accessories

31" DIA. D. FIR, DOUBLE BLAZED & SCRIBED "1/4 S 34 CS BT"
BEARS N 15 1/4° W, 204.7 FT.

Sketch of Monument, Acessories, and General Area

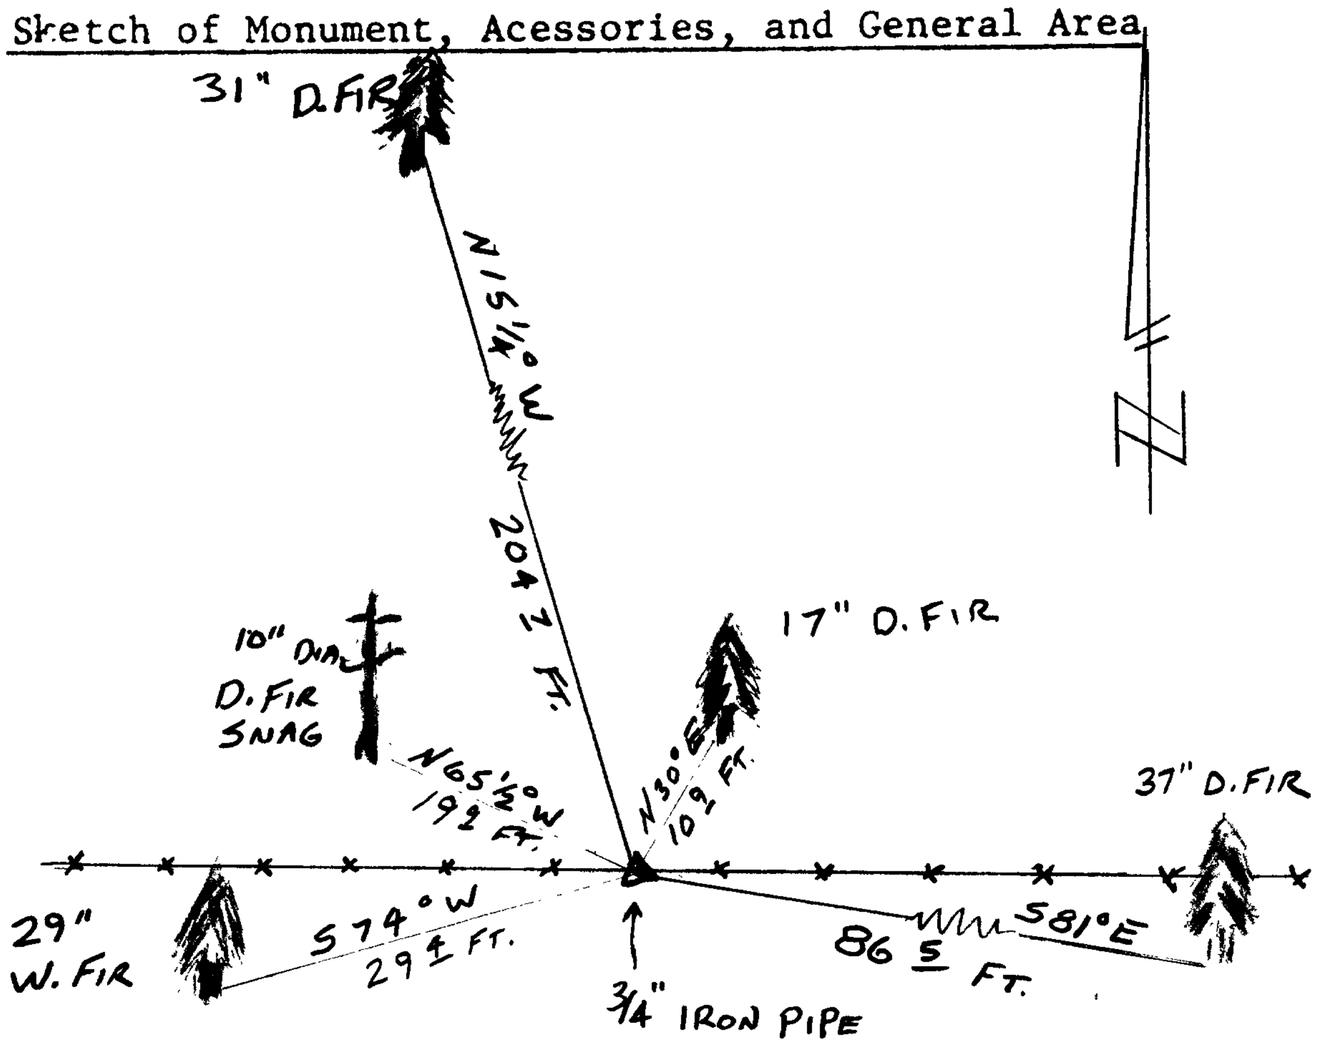


Location & Comments

CORNER LIES IN E-W FENCE WITH TIMBER TO SOUTH & ROLLING PASTURE TO NORTH.

Comp. Declin. 16 3/4° E
Agency D.C.S.O.
Party Chief S. FLAUSE
Notekeeper J. PIKE
Witnesses

Address

Surveyor's Seal

REGISTERED
PROFESSIONAL
LAND SURVEYOR

EXPIRES 6-30-06

OREGON
JULY 25, 1990
RANDALL W. SMITH
2469

67/14-15