FILED

Date: 10-18-2006 By: JC

This survey corrects of:

Map:

No.

Corner Plat: 67/14-29

DOUGLAS COUNTY SURVEYOR

GOVERNMENT CORNER RESTORATION FORM

Township 24S Range 7W Sec. 5 County DOUGLAS

State OR Date SEPT. 26, 2006 No. 240708

Corner Designation

NORTH 1/4 COR SEC. 5 ONLY

___ Condition Report Only
___ Not Found
✓ Renewed
___ Unrecorded
___ Surveyed In
___ Referenced Out

Previous Renewals 1963

MONUMENT DETAIL

Monument(s) Found: (Condition and Source)

3 1/4" DIA. B.L.M. BRASSCAP ON 2 1/2" I. PIPE FIRMLY SET PROJECTS 8" ABOVE GROUND.

U.S. CADASTRAL SURVEY - BUREAU OF LAND MANAGEMENT

1/4 S 5

T 24S R 7W

1963

Accessories Found:

9" NOW 14" DIA. X 1 1/2 FT. TALL ROTTED D. FIR STUMP. ILLEGIBLE REVERSE SCRIBE FOUND BEARS S 45° E, 72.6 FT. (AGREES W/REC.) 1963 BT

C.S. File No 67/14-29

RENEWAL

Monument Set (Procedure and Description)

N/A

Monument Detail

New Accessories

21" DIA. PEAR TREE, TAGGED, NOT SCRIBED, BEARS S 81 1/4° W, 139.1 FT.

20" DIA. APPLE TREE, TAGGED, NOT SCRIBED, BEARS N 46 3/4° W, 111.1 FT.

17" DIA. D. FIR, DOUBLE BLAZED & SCRIBED "1/4 S S CS BT" BEARS S 36 1/4° E, 46.4 FT

A 3 1/2" DIA. BRASS CAP ON A 2 1/2" I. PIPE PROT. ≈ 1 FT. ABOVE GROUND (S 1/4 SEC 32, T 23 S, R 12 W) BEARS N 89° 46' E 176 ± FT. DIST. (REC. N 89° 46' E 1755.6 FT.)

Sketch of Monument, Acessories, and General Area

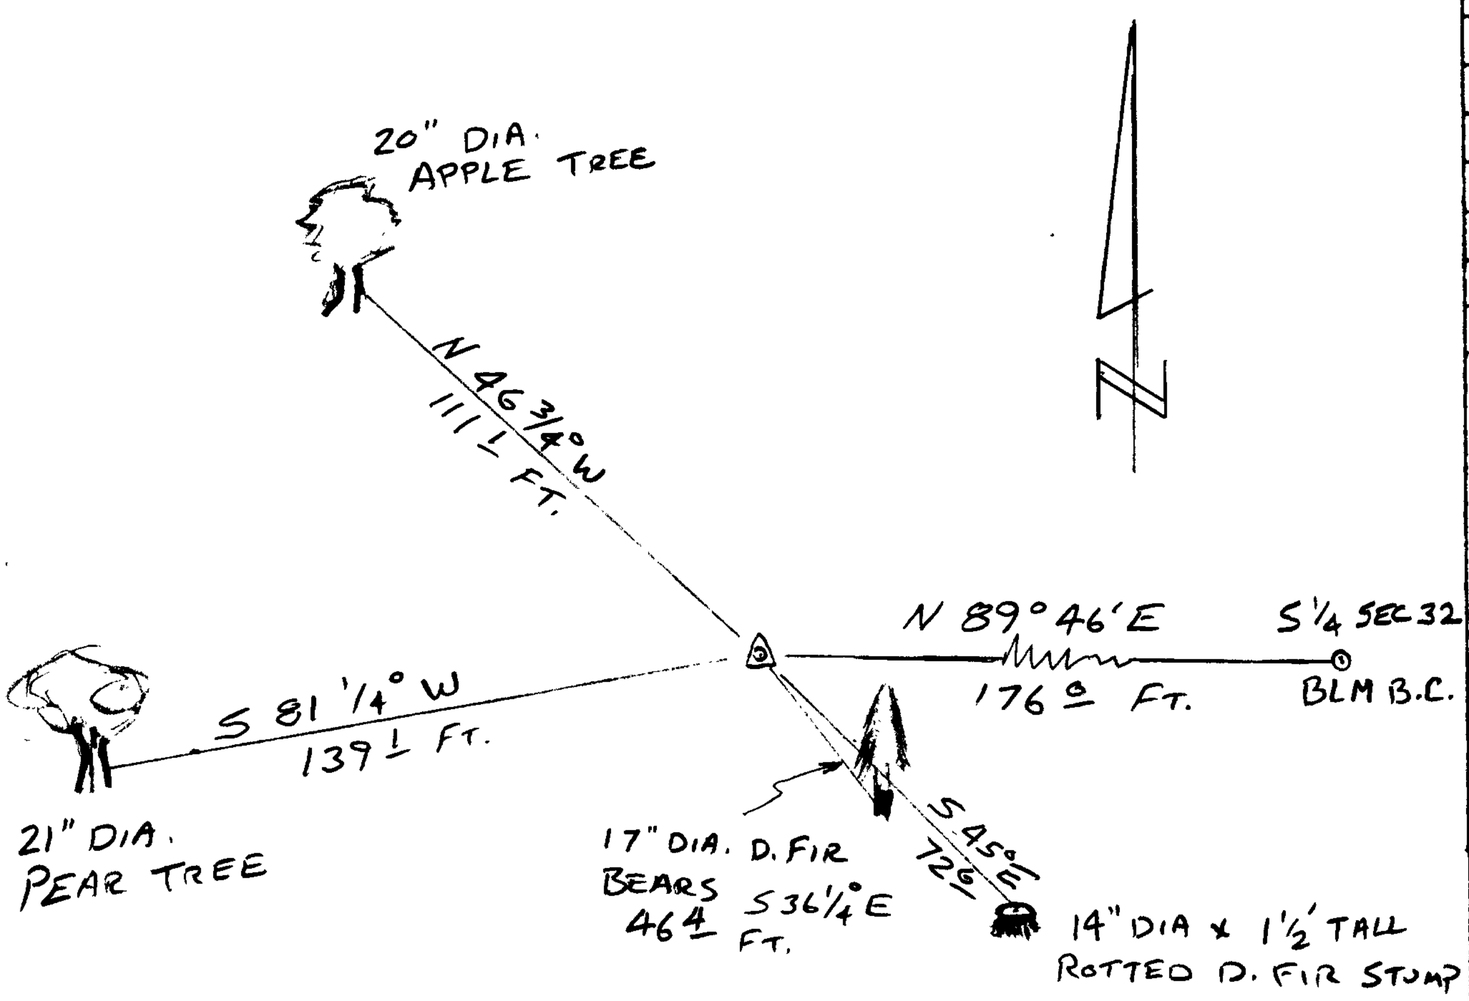

Location & Comments

LIES ON MODERATE EAST FACING SLOPE IN CLEARED PASTURE AREA APPROX. 140 FT EAST OF DIRT RD.

Comp. Declin. 16 1/2° E
Agency D.C.S.O.
Party Chief
Notekeeper
Witnesses

Address

Surveyor's Seal

REGISTERED PROFESSIONAL LAND SURVEYOR
RENEWAL 6-30-09
OREGON
JULY 25, 1990
RANDALL W. SMITH
2469

67/14-B