FILED

Date: 4/23/2007 By: JC

This survey consists of:

Map:

Narrative:

Corner Rpt: 67/21-25

GOVERNMENT CORNER RESTORATION FORM

Township 30 S Range 8 W Sec. 8 County DOUGLAS

State OR Date 4-16-2007 No. 240 500

Corner Designation

S 1/4 SEC. 8

DOUGLAS COUNTY SURVEYOR

___ Condition Report Only
___ Not Found
✓ Renewed
___ Unrecorded
___ Surveyed In
___ Referenced Out

Previous Renewals D.C.S.O. 1965

Monument(s) Found: (Condition and Source)

2 1/2" DIA BRASS CAP PROPERLY MARKED ON 1 1/4" O.D. I.P. PROJECTS 6" ABOVE GROUND FIRMLY SET

MONUMENT DETAIL

COUNTY SURVEYORS OFFICE
T 30 S
S 8
S 17
R 8 W
1965

Accessories Found:

- ORIG. 15" NOW 20" DIA. MADRONE, NOW DOWN, OUT OF POSITION SHOWS OPENED BLAZES, NO SCRIBING FOUND. BEARS S 32° W, 16.5 FT. (AGREES W/REC) O.B.T.
- 8" NOW 13" DIA. D. FIR, HEALED DOUBLE BLAZE VISIBLE BEARS S 67 1/2° W, 22.5 FT. (REC. S 71° W, 23.0 FT.) 1965 BT. POSSIBLE 1965 CREW READ WRONG SIDE OF COMPASS NEEDLE?
- 18" NOW 23" DIA. X 7 FT. TALL I. CEDAR STUMP. FULLY HEALED DOUBLE BLAZE VISIBLE, TOP OF STUMP CUT AT ANGLE TO SHED WATER, BEARS N 4° E, 29.1 FT. (AGREES W/REC) 1965 BT
- ORIG 24" MADRONE NOW ROOT HOLE, AGREES WELL W/REC. (N 34° W, 33.0 FT.) O.B.T.

C.S. File No 67/21-25

67/21-25

#75

RENEWAL

Monument Set (Procedure and Description)

Monument Detail

New Accessories

22" DIA. CHINQUAPIN, DOUBLE BLAZED & SCRIBED "1/4 S 17 CS BT"
BEARS S 21½° E, 30.6 FT.

6 DIA. G. FIR, DOUBLE BLAZED & SCRIBED "1/4 S 8 CS BT"
BEARS N 57½° W, 22.9 FT.

Sketch of Monument, Acessories, and General Area

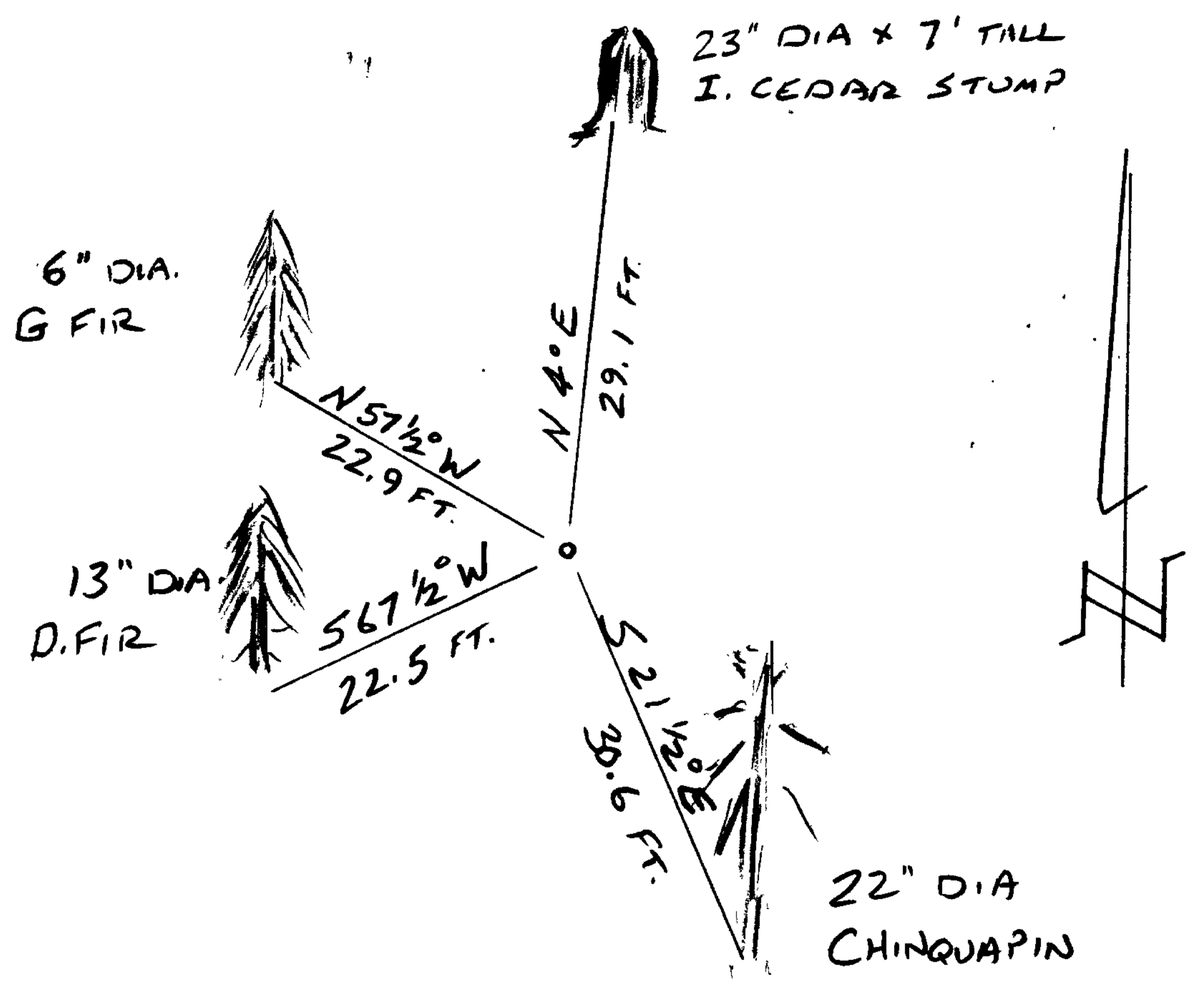

Location & Comments

CORNER LIES APPROX. 300 FT. SOUTH OF GRAVELLED Rd. ON S. SIDE OF RIDGE TOP.

C041612A

Comp. Declin. 16¼° E
Agency D.C.S.O.
Party Chief S. FLAUSE
Notekeeper J. PIKE
Witnesses

Address

Surveyor's Seal

REGISTERED PROFESSIONAL LAND SURVEYOR

Exp 12/05 6-30-08

OREGON
JULY 25, 1990
RANDALL W. SMITH
2469

67/21-25B