FILED
Date: 6/20/2007 By: JC
This survey consists of:
Map:
Narrative:
Corner Rpt: 67/21-40

GOVERNMENT CORNER RESTORATION FORM

Township 27S Range 6W Sec. 24 County DOUGLAS

State OR Date 6-7-07 No. 05308

Corner Designation

SE COR. LEISER
DLC # 53

DOUGLAS COUNTY
SURVEYOR

____ Condition Report Only
____ Not Found
✓ Renewed
____ Unrecorded
____ Surveyed In
____ Referenced Out

Previous Renewals 1917, 1950

MONUMENT DETAIL

Monument(s) Found: (Condition and Source)

2 1/2" I.D. GALV. IRON PIPE
FIRMLY SET, PROJECTS 6"
ABOVE GROUND. 1917 MONUMENT.

Accessories Found:

4" NOW 10" DIA. MADRONE, IS MOST WESTERLY IN CLUMP OF
3 STEMS. BLAZE NOT EVIDENT, AGE OF TREE CHECKS WELL
MOST WESTERLY TRUNK BEARS S 47°W, 17.5 FT. (AGREES W/REC.)
CENTER OF ROOT CROWN BEARS S 42°W, 17.5 FT. 1950 BT

NO TRACE OF ANY OTHER ACCESSORIES

C.S. File No 67/21-40

RENEWAL

Monument Set (Procedure and Description)

Monument Detail

New Accessories

7" DIA. W. OAK, DOUBLE BLAZED & SCRIBED "SEDLC 53 CS BT" BEARS N78¼°W, 19.8 FT.
6" DIA. B. OAK, DOUBLE BLAZED & SCRIBED "X" ON HIGH BLAZE & "CS BT" ON LOW BLAZE.
BEARS N 31½°E, 34.2 FT.
7" DIA. W. OAK, DOUBLE BLAZED & SCRIBED "X" ON HIGH BLAZE & "CS BT" ON LOW BLAZE
BEARS S 71°E, 15.7 FT.

Sketch of Monument, Acessories, and General Area

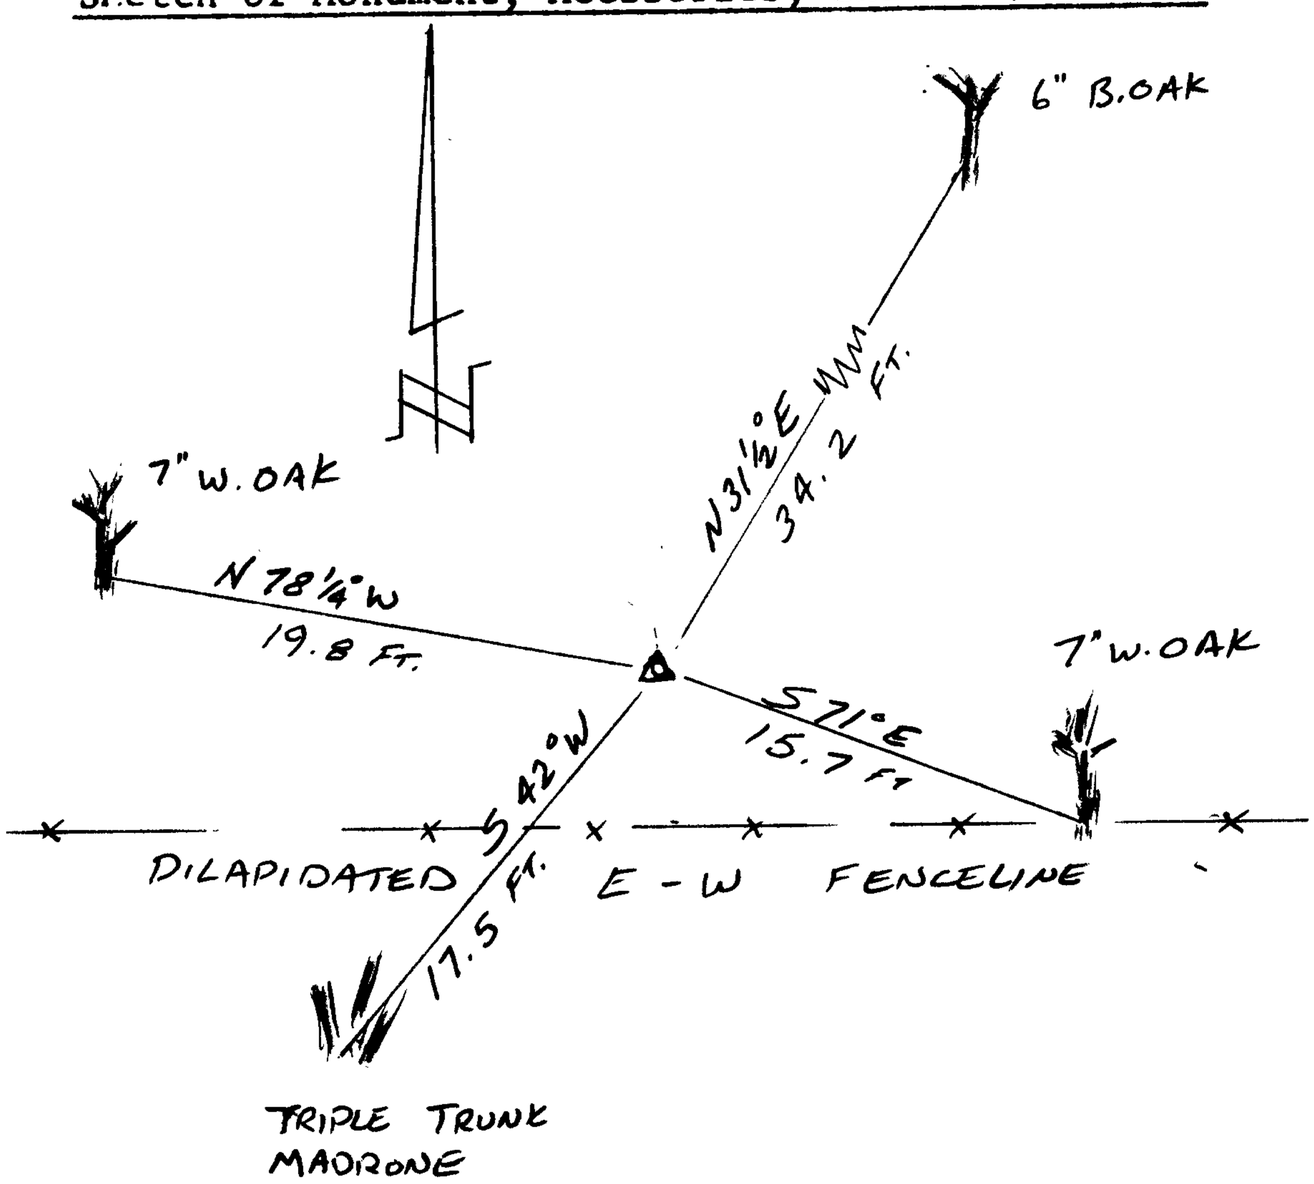

Location & Comments

CORNER LIES ON STEEP WEST FACING SLOPE. APPROX. 6 FT. NORTH OF DILAPIDATED E-W FENCELINE.

ETREX COORD. NAD 27 CONUS
N 43°12' 33.5"
W 123°21' 46.0"

Comp. Declin. 16¼°E
Agency D.C.S.O.
Party Chief S. FLAUSE
Notekeeper J. PIKE
Witnesses

Address

Surveyor's Seal

REGISTERED
PROFESSIONAL
LAND SURVEYOR

Renewal 6-30-08

OREGON
JULY 25, 1990
RANDALL W. SMITH
2400