FILED

GOVERNMENT CORNER RESTORATION FORM

Date: 10/16/2007 By: X

This survey consists of:
Map:
Narrative:
Corner Rpt: 67/24-30

DOUGLAS COUNTY SURVEYOR

Township 26S Range 3W Sec. 6 County DOUGLAS

State OR Date 10/8/07 No. 140700

Corner Designation

N 1/4 SEC. 6

___ Condition Report Only
___ Not Found
✓ Renewed
___ Unrecorded
___ Surveyed In
___ Referenced Out

Previous Renewals 1943, 1962, 1966

MONUMENT DETAIL

Monument(s) Found: (Condition and Source)

2 1/2" DIA. BRASS CAP PROPERLY MARKED ON 1" O.D. IRON PIPE FIRMLY SET PROJECTS 8" ABOVE GROUND.

1 1/4" DIA IRON PIPE LOOKED FOR AND NOT FOUND. (1922 CORNER)

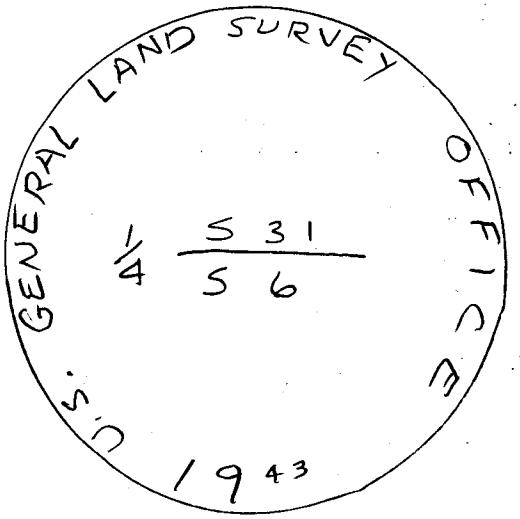

Accessories Found:

- ROOT HOLE WITH BITS OF BURNT BARK FITS WELL WITH RECORD (N26°E, 7.3 FT) 1943 BT.
- ROOT HOLE DEPRESSION FITS WELL TO SE (REC. S11°E 12.8 FT)
- NO SIGN OF ANY OTHER ACCESSORIES NOTED

C.S. File No 67/24-30

RENEWAL

Monument Set (Procedure and Description)

Monument Detail

New Accessories

- 3"x3" 'X' CHISELED ONTO 2 FT X 2FT. X 3 FT. TALL POINTED STONE, BEARS N 18° W 56.6 FT.
- PISTOL BUTT MAPLE, 11" DIA DOUBLE BLAZED & SCRIBED "1/4 S 6 CS BT" CENTER OF ROOT CROWN BEARS S 14° W, 138.8 FT.
- 3" X 3" 'X' CHISELED ONTO 8 FT X 2 FT X 2½ FT. TALL STONE, 'X' IS APROX 1.2 FT BELOW HIGHEST POINT ON STONE, BEARS N 25° E. 230.4 FT.
- DOUBLE TRUNK MAPLE, WESTERLY TRUNK IS 24" DIA. BURNT, Hollow, MKD 'X BT' ON HIGH SINGLE BLADE CENTER OF ROOT CROWN BEARS S 80 ½° E, 197.9 FT.
- NEARBY SURVEY MONUMENT SIGN BEARS EAST, 1 FT.

Sketch of Monument, Acessories, and General Area

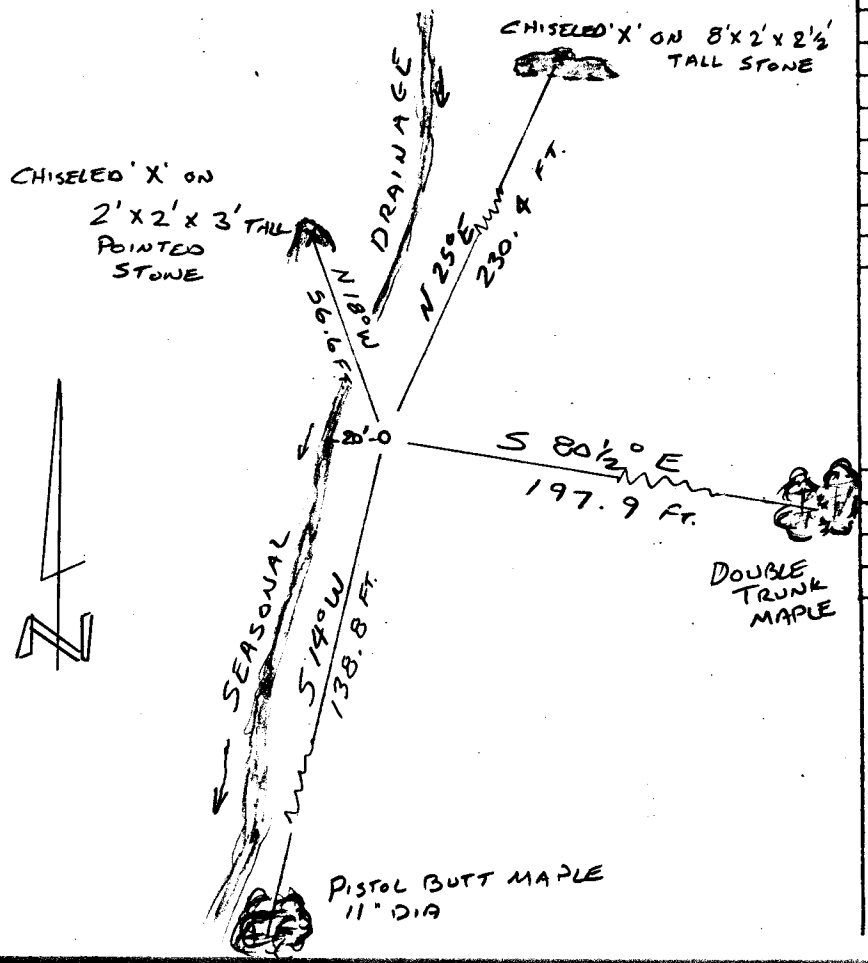

Location & Comments

EAST-WEST FENCE TO SOUTH NOW REMOVED. CORNER LIES IN AREA THAT APPEARS TO BE PERIODICALLY BURNED.

Comp. Declin. 16¼° E
Agency D.C.S.O.
Party Chief S. FLAUSE
Notekeeper J. PIKE
Witnesses

Address

Surveyor's Seal

REGISTERED PROFESSIONAL LAND SURVEYOR

Randall W. Smith
RENEWAL 6-30-08

OREGON
JULY 25, 1990
RANDALL W. SMITH
2488