FILED

GOVERNMENT CORNER RESTORATION FORM

Date: 12-4-07 By: JC

This survey consists of:
Map:
Narrative:
Corner Rpt: 67/24-43

Township 26 S Range 3 W Sec. 1 County DOUGLAS

State OR Date Nov. 8, 2007 No. 600700

Corner Designation

T. 25-3

S 35	S 36
S 2	S 1

T. 26-3

DOUGLAS COUNTY SURVEYOR

___ Condition Report Only
___ Not Found
✓ Renewed
___ Unrecorded
___ Surveyed In
___ Referenced Out

Previous Renewals

Monument(s) Found: (Condition and Source)

2½" DIA. BRASS CAP PROPERLY MARKED ON 2" O.D. IRON PIPE, PROJECTS 14" ABOVE GROUND IN MOUND OF STONES.

MONUMENT DETAIL

U.S. GENERAL LAND OFFICE SURVEY
T25S R3W
S35 S36
S2 S1
T26S
1943

Accessories Found:

- 20" NOW 31" DIA. X 1½ FT. TALL D. FIR STUMP. TAGGED, NO MARKS VISIBLE BEARS N30°E, 6.0 FT. (REC. N30°E, 5.3 FT.) 1943 BT.
- 24" NOW 40" DIA. X 2½ FT. TALL D. FIR STUMP. TAGGED, HEALED ROTTEN BLAZE BEARS S72°E, 53.5 FT. (AGREES W/REC) 1943 BT
- 20" NOW 29" DIA. X 4 FT. TALL D. FIR STUMP. TAGGED, BURLING VISIBLE ON ROTTING STUMP BEARS S84°W, 33.0 FT. (AGREES W/REC) 1943 BT
- 20" NOW 34" DIA D. FIR, HEALED BLAZE, BEARS N57½°W, 26.4 FT. (AGREES W/REC) 1943 BT

C.S. File No 67/24-43

RENEWAL

Monument Set (Procedure and Description)

Monument Detail

New Accessories

8" DIA. HEMLOCK, DOUBLE BLAZED & SCRIBED "T26S R3W S1 CS BT"
BEARS S 13°E, 40.7 FT.
6" DIA. CHINQUAPIN, DOUBLE BLAZED & SCRIBED "T26S R3W S2 CS BT"
BEARS S 24½°W, 18.0 FT.

Sketch of Monument, Acessories, and General Area

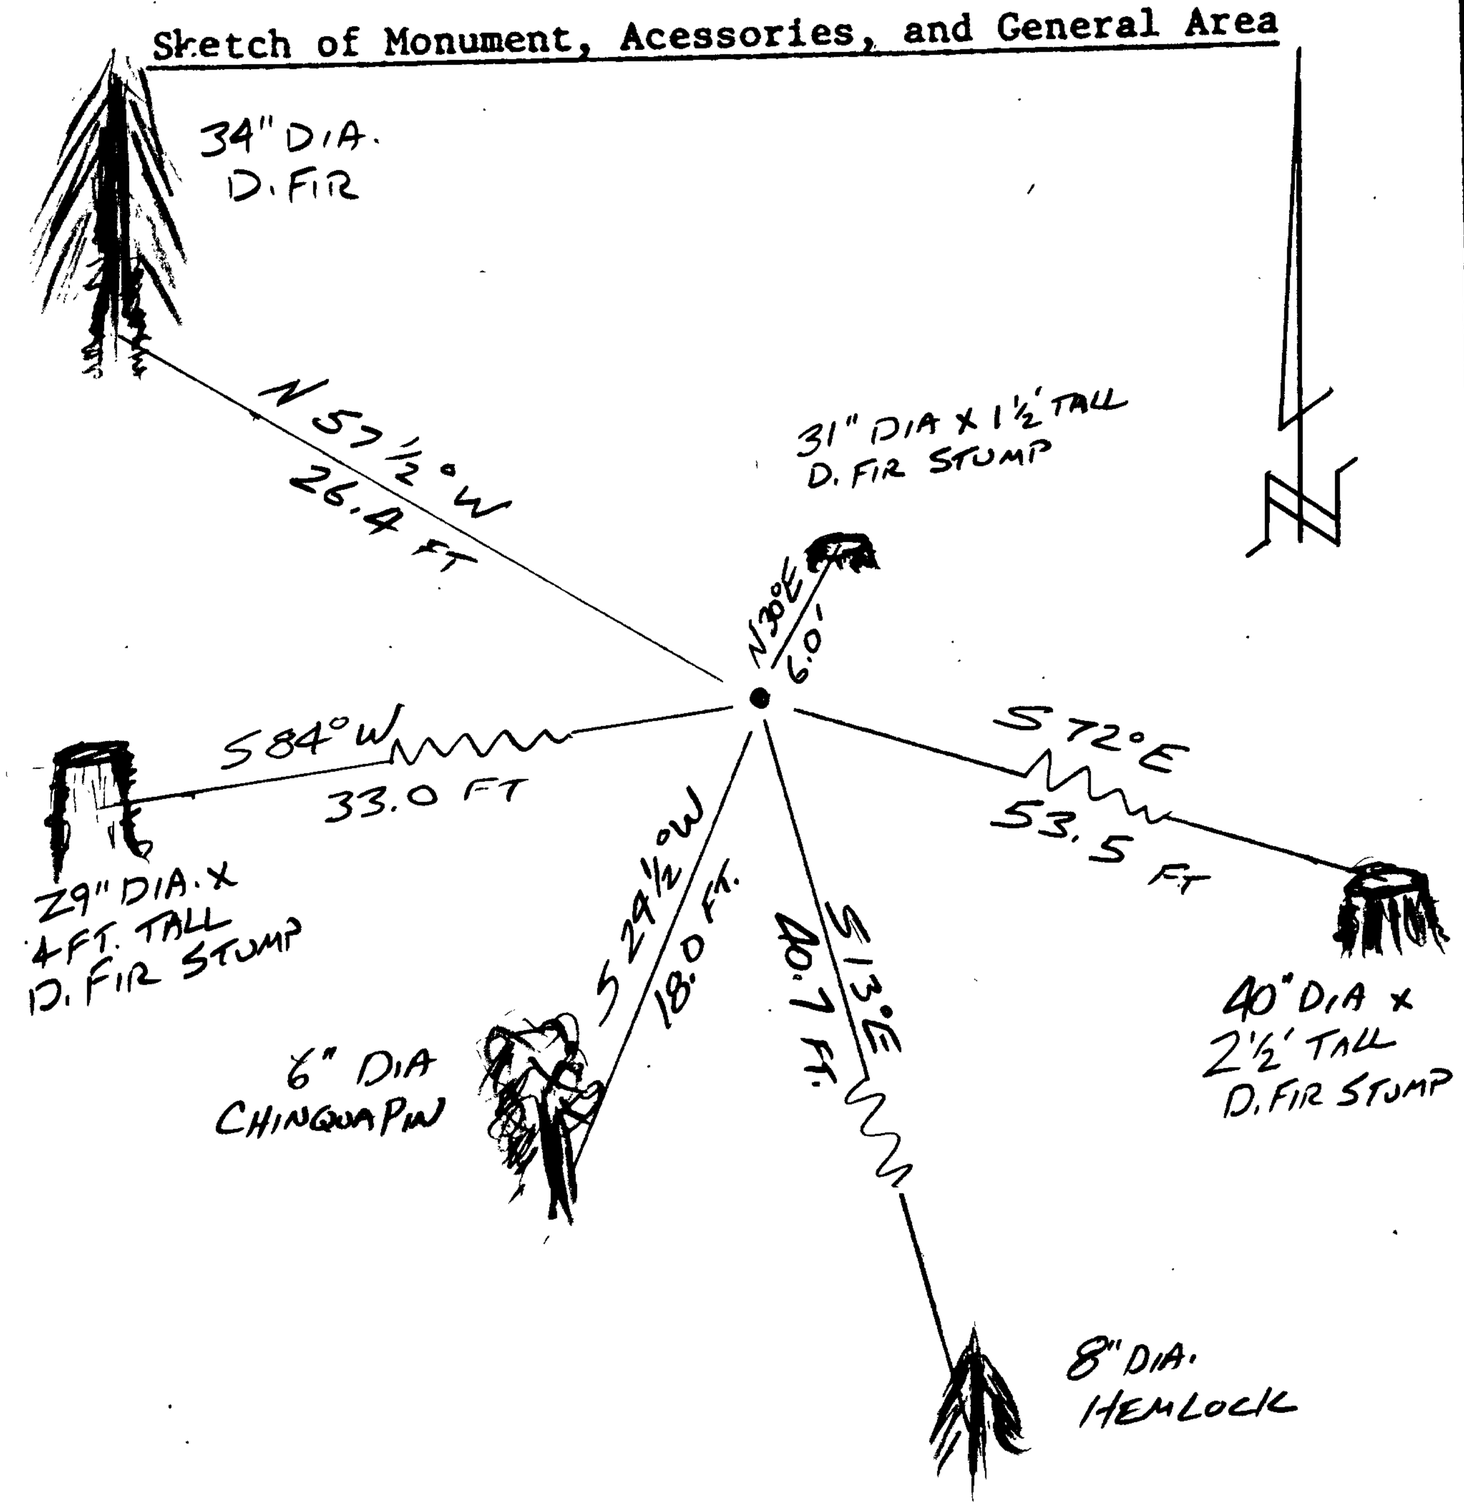

Location & Comments

CORNER LAYS ON NEARLY FLAT E-W BENCH.

C 110&11A

Comp. Declin. 16¼° E
Agency D.C.S.O.
Party Chief S. FLAUSE
Notekeeper J. PIKE
Witnesses

Address

Surveyor's Seal

REGISTERED
PROFESSIONAL
LAND SURVEYOR

Randall W. Smith
RENEWAL 6-30-08

OREGON
JULY 28, 1990
RANDALL W. SMITH
2488